

MAY 22 1997
COMMISSION

LIBER 16850 PG 376

DEC 19 96 306281

LAND CORNER RECORDATION CERTIFICATE 9.00 MISCELLANEOUS RECORDING
Filing Requirement of Act 74, Mich. P.A. 1970 2.00 REMONUMENTATION

For corners in

Oakland

(County)

Located In: Orion Twp Corner Code #

- 1. Public Land Survey T 4N R 10E G-1
T ___ R ___
T ___ R ___
T ___ R ___
- 2. Property Controlling S ___ T ___ R ___
in Section S ___ T ___ R ___
- 3. Miscellaneous S ___ T ___ R ___
Property in Sec. S ___ T ___ R ___

19 DEC 96 10:55 A.M. RECEIPT# 16B
PAID RECORDED - OAKLAND COUNTY
LYNN D. ALLEN, CLERK/REGISTER OF DEEDS

Compliance with
ACT 345, P.A. 1990

APPROVED ON: 11-26-96 JS
OAKLAND COUNTY REMONUMENTATION
PEER GROUP COMMITTEE

Register of Deeds Stamp & File Number

- 4. Lot No. _____, Recorded Plat _____
- 5. Private Claims _____

Huston K. Kennedy, in a field survey on 11/6, 19 96 do hereby state that under requirements of P.A. 74, Michigan P.A. of 1970, the corner points mentioned in lines 1 and 2 above were in conformance with regulations and rules therefore as required in the current manual of survey instructions of the United States Department of the Interior, Bureau of Land Management or by a decree of a Court of Law and /or that the corner points mentioned in lines 3, 4 and 5 above were in conformance with the rules of the Michigan Board of Land Surveyors or by a Decree of a Court of Law; established, re-established, monumented, recovered, found as expressed below:

NOTE: Not more than 2 corners, all in the same town and range, may be recorded on this certificate.

A	B	C	D	E	F	G	H	I	J	K	L
1											
2	6		5		4		3		2		1
3											
4	7		8		9		10		11		12
5											
6	10		17		16		15		14		13
7											
8	19		20		21		22		23		24
9											
10	30		29		28		27		26		25
11											
12	31		32		33		34		35		36
13											

- A. Description of original monument and accessories and/or subsequent restoration;
1817-GLO Wampler, D.S.; Set Post 12" White Oak S24 E 68 Links; 3" White Oak N28 E 67 Links
1.) 1991-Patterson, PS #17631; LCRC L.12172, Pg.707 - Fnd 1/2" Pipe in concrete in a 4" Iron Pipe
2.) 1995-Kennedy, PS #17623; LCRC L.15517, Pg.405 - Fnd 5/8" Iron Pipe in concrete.

- B. Description of corner evidence found and/or method applied in restoring or reestablishing corner:
1996 Kennedy Surveying, Inc. - Kennedy, PS #17623 - Fnd 5/8" Iron Pipe in concrete in a 4" pipe w/2" diameter brass cap stamped Oakland County Remonumentation, PS #17623 located in a tree-fence line extending East & West 17.5 feet North of the existing centerline of Nakomas Road extending to the East & West, which has a gravel surface and 21 feet East of driveway for house #1437. Found 1/2 Iron Rod 430.40 feet (R&H) to the East, also found fence corner 59.50 feet to the South. This corner is also being accepted an used as a common corner with Sections 33 & 34, T5N, R10E, Oxford Twp., (G-13).

Witnesses from LCRC # 1 & 2 and "SUPERVISOR'S PLAT NO. 7", Liber 27, Page 47 of Oakland County Records were used to recover and verify the location of the found 5/8" Iron Pipe in concrete in a 4" pipe w/2" diameter brass cap stamped Oakland County Remonumentation, PS #17623.


I accepted the found 5/8" Iron Pipe in concrete in a 4" pipe w/2" diameter brass cap stamped Oakland County Remonumentation, PS #17623 as the best evidence of the original corner position. Field Measurements see back side of LCRC

- C. Description of monument for corner and accessories established to perpetuate locating the position of the corner:
G-1 I accepted the 5/8" Iron Pipe in concrete in a 4" pipe a 2" diameter brass cap stamped Oakland County Remonumentation, PS #1762:
N87 E 15.05' Fnd PK & Remon Washer South face 17" Oak
N81 W 3.45' Fnd PK & Remon Washer NE face 19" Oak
S80 W 16.38' Fnd PK & Remon Washer SK face 15" Oak
S23 E 42.12' Fnd PK & Remon Washer SE face 22" Cherry

The selected location is accepted by me and is generally accepted by Professional Surveyors as the best available evidence position of the original corner.

Signed by [Signature]
Surveyor's Michigan License No. 17623

Date 11-27-96

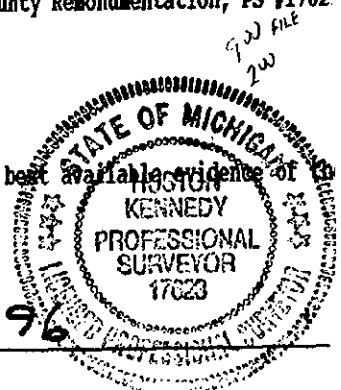

COPY

LIBER 16850 PG 377

**SURVEY &
REMONUMENTATION**

MAY 22 1997

COMMISSION

FIELD MEASUREMENTS BETWEEN

G-1 to G-2 GLO - 44 Chains or 2904.00Ft., 3003.65 Ft. (MEA 1996)