

**COPY**

LIBER 16874 PG 111

**LAND CORNER RECORDATION CERTIFICATE**  
Filing Requirement of Act 74, Mich. P.A. 1970

For corners in

Oakland

(County)

Located in: Orion Twp Corner Code #

1. Public Land Survey	T	4N	R	10E	G-3
	T		R		
	T		R		
	T		R		
2. Property Controlling in Section	S	T	R		
	S	T	R		
3. Miscellaneous Property in Sec.	S	T	R		
	S	T	R		

\$ 9.00 MISCELLANEOUS RECORDING  
 \$ 2.00 REMONUMENTATION  
 3 JAN 97 7:45 A.M. RECEIPT# 78  
 PAID RECORDED - OAKLAND COUNTY  
 LYNN D. ALLEN, CLERK/REGISTER OF DEEDS

Compliance with  
ACT 345, P.A. 1999

APPROVED ON: 12-17-96 FS  
 OAKLAND COUNTY REGISTER OF DEEDS  
 PEER GROUP (DATE)

Register of Deeds Stamp & File Number

4. Lot No. \_\_\_\_\_, Recorded Plat \_\_\_\_\_  
 5. Private Claims \_\_\_\_\_

I, Huston K. Kennedy, in a field survey on 11/25, 1996 do hereby state that under requirements of P.A. 74, Michigan P.A. of 1970, the corner points mentioned in lines 1 and 2 above were in conformance with regulations and rules therefore as required in the current manual of survey instructions of the United States Department of the Interior, Bureau of Land Management or by a decree of a Court of Law and/or that the corner points mentioned in lines 3, 4 and 5 above were in conformance with the rules of the Michigan Board of Land Surveyors or by a Decree of a Court of Law; established, re-established, monumented, recovered, found as expressed below:

NOTE: Not more than 2 corners, all in the same town and range, may be recorded on this certificate.

1	A	B	C	D	E	F	G	H	I	J	K	L
2		6		5		4		3		2		1
3							●					
4		7		8		9		10		11		12
5												
6		16		17		16		15		14		13
7												
8		19		20		21		22		23		24
9												
10		30		29		28		27		26		25
11												
12		31		32		33		34		35		36
13												

A. Description of original monument and accessories and/or subsequent restoration:

- 1817-GLO Wampler, D.S.; Set Post 35" White Oak S34°E 134 Links
- 1.) 1977-Graham, PS #14864; LCRC L.7059, Pg.236 - Fnd 1/2" Crimped Iron Pipe
- 2.) 1991-Kennedy, PS #17623; LCRC L.12168, Pg.643 - Fnd 1/2" Iron Rod
- 3.) 1991-Hoben, PS #34995; LCRC L.12236, Pg.225 - Fnd 1/2" Iron Rod in a Monument Box
- 4.) Kohn, PS #26459; LCRC L.14441, Pg.111 - Fnd 1/2" Re-rod in a Monument Box

**SURVEY &  
 REMONUMENTATION**  
 MAY 22 1997  
 COMMISSION

B. Description of corner evidence found and/or method applied in restoring or reestablishing corner:

1996 Kennedy Surveying, Inc. - Kennedy, PS #17623 - Fnd 1/2" Iron Rod in a Monument Box .50 feet West of the existing centerline of Joslyn Road extending to the North & South, which has a bituminous surface. There is a chain link fence extending to the East. G-3 is the point of beginning for "MARINA POINTE" a plat recorded in Liber 232 of plats, on pages 11-18 of Oakland County Records.

Witnesses from LCRC #2, 3, 4 and "MARINA POINTE" were used to recover and verify the location of the found 1/2" Iron Rod in Monument Box.

I accepted the found 1/2" Iron Rod in a Monument Box as the best evidence of the original corner position.

Field Measurements see back side of LCRC


C. Description of monument for corner and accessories established to perpetuate locating the position of the corner:

- G-3 I replaced the found 1/2" Iron Rod with a 5/8" x 24" Iron Rod w/2" diameter brass cap stamped Oakland County Remonumentation, #17623 in a existing Monument Box
- Due East 33.30' 3" Steel Fence Post
- S33°E 93.05' NW corner Brick Pump House
- N63°W 39.45' Set PK & Remon Washer SW face 9" Box Elder
- N31°W 85.85' Sign Post
- Due East 43.00 Ft. Concrete Monument

The selected location is accepted by me and is generally accepted by Professional Surveyors as the best professional evidence of the position of the original corner.

Signed by [Signature]  
 Surveyor's Michigan License No. 17623

Date 12-16-96

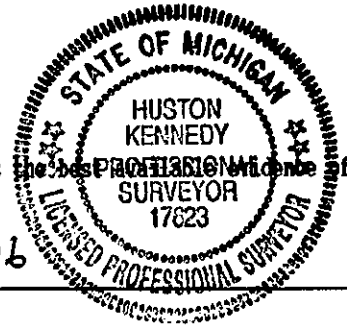

**COPY**

118ER 168740112

**SURVEY &  
REMONUMENTATION**

MAY 22 1997

COMMISSION

**FIELD MEASUREMENTS BETWEEN**

G-3 to F-3 GLO = 40.50 chains or 2673.00 Ft., 2845.71 Ft. (MEA 1996)  
G-3 to G-2 GLO = 40 chains or 2640.00 Ft., 2644.86 Ft., (MEA 1996)  
G-3 to G-4 corner falls in a lake