

OK - T. SMITH

MAY - 1 1995

LAND CORNER RECORDATION CERTIFICATE

Filing Requirement of Act 74, Mich. P.A. 1970

\$ 7.00 MISCELLANEOUS RECORDING
\$ 2.00 REMONUMENTATION
20 JAN 95 7:26 A.M. RECEIPT# 5B
PAID RECORDED - OAKLAND COUNTY
LYNN D. ALLEN, CLERK/REGISTER OF DEEDS

For corners in

COMMISSION

Oakland (County) Located In: Orion Twp. Corner Code #/


1. Public Land Survey	T 4N	R 10E	G-10
	T	R	
	T	R	
	T	R	
2. Property Controlling in Section	S	T	R
	S	T	R
3. Miscellaneous Property in Sec.	S	T	R
	S	T	R

Compliance with ACT 345, P.A. 1990
APPROVED ON: 9-14-94
OAKLAND COUNTY REMONUMENTATION PEER GROUP COMMITTEE
Register of Deeds Stamp & File Number

- 4. Lot No. _____, Recorded Plat _____
- 5. Private Claims _____

I, Huston K. Kennedy, in a field survey on August 1, 19 94, do hereby certify that under requirements of P.A. 74, Michigan P.A. of 1970, the corner points mentioned in lines 1 and 2 above were in conformance with regulations and rules therefore as required in the current manual of survey instructions of the United States Department of the Interior, Bureau of Land Management or by a decree of a Court of Law and/or that the corner points mentioned in lines 3, 4 and 5 above were in conformance with the rules of the Michigan Board of Land Surveyors or by a Decree of a Court of Law: established, re-established, monumented, re-monumented, recovered, found as expressed below:

NOTE: Not more than 4 corners, all in the same town and range, may be recorded on this certificate.

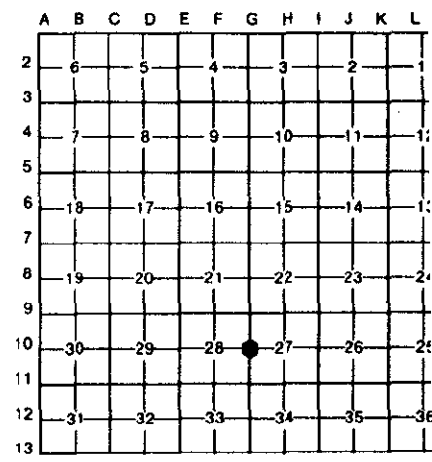

A. Description of original monument and accessories and/or subsequent restoration:

- 1817-GLO Wampler, D.S.; Set Post; 4" Black Oak S41*W 79 Links; 6" Black Oak N41*E 67 Links;
- 1.) 1979-Heil, P.S. #18993; LCRC L.7590, Pg.48 - Fnd Iron Rod
- 2.) 1989-Wilkerson, P.S. #21584; LCRC L.10876, Pg.703 - Fnd 3/8" Iron Rod
- 3.) 1992-Kennedy, P.S. #17623; LCRC L.12730, Pg.862 - Fnd 3/8" Iron
- 4.) 1978-Henderson, P.S. #16043; Survey L.7360, Pg.657 - Fnd 3/8" Iron Rod
- 5.) 1978-Heil, P.S. #18993; Survey L.7590, Pg.37 - Fnd Iron Rod, used same wit as 1979 LCRC
- 6.) 1992-Kennedy, P.S. #17623; Survey L.13842, Pg.800 - Fnd 3/8" Iron Rod, used same wit as 1992 LCRC

B. Description of corner evidence found and/or method applied in restoring or reestablishing corner:

1994 Kennedy Surveying, Inc. Kennedy, P.S. #17623 - Fnd 3/8" Iron Rod .70' South to a fence line extending East-West, also Detroit Edison South Right-of-Way line.


Witnesses from LCRC #2 & 3 were used to recover and verify the location of the found 3/8" Iron Rod.

I accepted the found 3/8" Iron Rod as the best evidence of the original corner position.

C. Description of monument for corner and accessories established to perpetuate locating the position of the corner:

- G-10 I replaced the found 3/8" Iron Rod with 1/2" Iron Rod encased in a 4" diameter concrete cylinder 36" dia. cap stamped Oakland County Remonumentation, PS #17623
- S03°W 11.63' Set PK & Remon. Washer East face 29" Oak
- S71°W 15.55' Set PK & Remon. Washer North face 22" Oak
- S32°E 12.65' Set PK & Remon. Washer NE face 8" Cherry
- S87°E 22.87' Set PK & Remon. Washer North face 24" Oak

The selected location is accepted by me and is generally accepted by Professional Surveyors as the best position of the original corner.

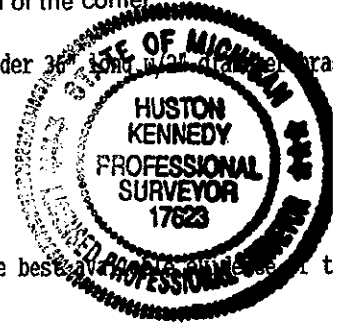

Signed by [Signature]
Surveyor's Michigan License No. 17623

Date December 17, 1994