

**SURVEY & REMONUMENTATION**

LIBER 15225 PG 652

JAN 27 1995 016438

MAY - 1 1995

**LAND CORNER RECORDATION CERTIFICATE**  
Filing Requirement of Act 74, Mich. P.A. 1970

OK - T. SMITH

For corners in

Oakland **COMMISSION**  
(County)

Located In: Orion Twp. Corner Code #


1. Public Land Survey	T 4N	R 10E	I-9
	T	R	
	T	R	
	T	R	
2. Property Controlling in Section	S	T	R
	S	T	R
3. Miscellaneous Property in Sec.	S	T	R
	S	T	R

\$ 9.00 MISCELLANEOUS RECORDING  
\$ 2.00 REMONUMENTATION  
27 JAN 95 11:00 A.M. RECEIPT# 76B  
PAID RECORDED - OAKLAND COUNTY  
LYNN D. ALLEN, CLERK/REGISTER OF DEEDS  
Compliance with  
ACT 345, P.A. 1990

APPROVED ON: 12-29-94  
OAKLAND COUNTY REMONUMENTATION  
PEER GROUP COMMITTEE  
Register of Deeds Stamp & File Number

4. Lot No. \_\_\_\_\_, Recorded Plat \_\_\_\_\_  
5. Private Claims \_\_\_\_\_

I, Huston K. Kennedy in a field survey on December 20, 19 95, do hereby certify that under requirements of P.A. 74, Michigan P.A. of 1970, the corner points mentioned in lines 1 and 2 above were in conformance with regulations and rules therefore as required in the current manual of survey instructions of the United States Department of the Interior, Bureau of Land Management or by a decree of a Court of Law and/or that the corner points mentioned in lines 3, 4 and 5 above were in conformance with the rules of the Michigan Board of Land Surveyors or by a Decree of a Court of Law; established, re-established, monumented, re-monumented, recovered, found as expressed below:

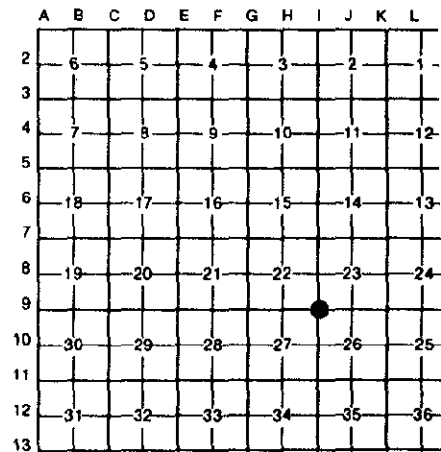

**NOTE: Not more than 4 corners, all in the same town and range, may be recorded on this certificate.**

**A. Description of original monument and accessories and/or subsequent restoration:**

- 1817-GLO Wampler, D.S.; Set Post; 3" Tamarac S47°E 18 Links; 8" Tamarac N43°E 4 Links  
1.) 1974-Smith, P.S. #21582; Unrecorded Survey - Fnd 1/2" Iron Rod  
2.) 1990-Carlson, P.E./P.S. #9189; Unrecorded Survey - Fnd Lathe at fence int.

*Handwritten signature/initials*

**B. Description of corner evidence found and/or method applied in restoring or reestablishing corner:**

1994 Kennedy Surveying, Inc. - Kennedy, P.S. #17623 - Fnd 1/2" Iron Rod 4" below water's surface, and a tree-fence line extending to the North, South, East & West.

Witnesses from unrecorded survey #2 were used to recover and verify the location of the found 1/2" Iron Rod, which I did not accept as the corner.

James Smith, P.S. #21582, did a unrecorded Certificate of Survey on September 2, 1974, and found a 1 1/4" pipe at the Northwest corner of "VERNIER FARMS" also found a 1/2" Iron Rod at a fence corner on the section line. I did accept the position of the corner as per this survey.

**FIELD MEASUREMENTS BETWEEN**

- I-9 to J-9 2178.13 Ft.
- I-9 to H-9 2677.47 Ft.

**C. Description of monument for corner and accessories established to perpetuate locating the position of the corner:**

- I-9 I replaced the found 1/2" Iron Rod with a 5/8" x 60" Iron Rod w/2" diameter brass cap stamped Oakland County Remonumentation, PS #17623  
N01°E 3.14' Set PK & Remon. Washer West face 12" Maple  
N09°E 26.83' Set PK & Remon. Washer NE face 14" Maple  
S65°E 26.83' Set PK & Remon. Washer North face 32" Maple  
S03°E 10.08' Set PK & Remon. Washer West face 14" Maple

The selected location is accepted by me and is generally accepted by Professional Surveyors as the best practical location of the position of the original corner.



Signed by [Signature]  
Surveyor's Michigan License No. 17623

Date January 18, 1995