SURVEY & REMONUMENTATION

MAY - 1 1995

COMMISSION

LIBER 14960 PG 094

OK - T. SMITH

94 242424

**LAND CORNER RECORDATION CERTIFICATE**

**Filing Requirement of Act 74, Mich. P.A. 1970**

For corners in Oakland (County) Located In: Orion Township Corner Code #

$ 7.00 MISCELLANEOUS RECORDING
$ 2.00 REMONUMENTATION
8 SEP 94 3:16 P.M. RECEIPT# 134B
PAID RECORDED - OAKLAND COUNTY
LYNN D. ALLEN, CLERK/REGISTER OF DEEDS

Compliance with ACT 345, P.A. 1990
APPROVED ON: 1-5-94
OAKLAND COUNTY REMONUMENTATION PEER GROUP COMMITTEE

Register of Deeds Stamp & File Number

| | | | | |
|---|---|---|---|---|
| 1. Public Land Survey | | T 4 N | R 10 E | J-5 |
| | | T ___ | R ___ | |
| | | T ___ | R ___ | |
| | | T ___ | R ___ | |
| 2. Property Controlling | S ___ | T ___ | R ___ | |
| in Section | S ___ | T ___ | R ___ | |
| 3. Miscellaneous | S ___ | T ___ | R ___ | |
| Property in Sec. | S ___ | T ___ | R ___ | |

4. Lot No. _____ , Recorded Plat _____
5. Private Claims _____

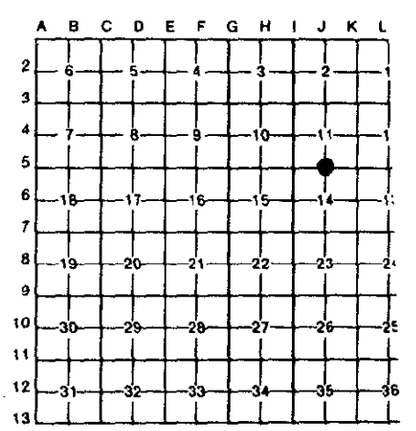


I, Huston K. Kennedy, in a field survey on November 18, 19 93, do hereby certify that under requirements of P.A. 74, Michigan P.A. of 1970, the corner points mentioned in lines 1 and 2 above were in conformance with regulations and rules therefore as required in the current manual of survey instructions of the United States Department of the Interior, Bureau of Land Management or by a decree of a Court of Law and/or that the corner points mentioned in lines 3, 4 and 5 above were in conformance with the rules of the Michigan Board of Land Surveyors or by a Decree of a Court of Law; established, re-established, monumented, re-monumented, recovered, found as expressed below:

**NOTE: Not more than 4 corners, all in the same town and range, may be recorded on this certificate.**

A. Description of original monument and accessories and/or subsequent restoration:

1817-GLO Wampler, D.S.; Set Post; 12" White Oak S71°W 18 Lnks; 6" White Oak N35°E 12 Lnks
1978-Buckerfield, P.S. #10868; LCRC L.7283, Pg.214-215 - Fnd PK Nail and flasher
1991-Buckerfield, P.S. #10868; Surveys L.11785, Pg.442-466 - Fnd PK Nail

B. Description of corner evidence found and/or method applied in restoring or reestablishing corner:

1993 Kennedy Surveying, Inc. - Kennedy, P.S. #17623 - Fnd a PK Nail located in the centerline of Clarkston Road, which is bituminous surface.

Witness points from the 1991 surveys were found and they were used to recover and verify the found PK Nail.

I accepted the found PK Nail as the best evidence of the original corner position.

C. Description of monument for corner and accessories established to perpetuate locating the position of the corner:

J-5 I replaced the found PK Nail with a 5/8" x 24" iron rod with a 2" diameter cap stamped Oakland County Remonumentation P.S. #17623 in a monument box.

S32°W-45.49 ft-Set PK & Remon. Washer East face 42" Oak
N04°W-72.30 ft-SW corner of house #190
N32°E-96.48 ft-SW corner of house #184
N58°W-58.85 ft-East face 4" corner fence post

The selected location is accepted by me and is generally accepted by Professional Surveyors as the best available evidence of the position of the original position.

STATE OF MICHIGAN HUSTON KENNEDY PROFESSIONAL SURVEYOR 17623 LICENSED PROFESSIONAL SURVEYOR

Signed by _____ Date June 20, 1994

Surveyor's Michigan License No. 17623

FORM APPROVED BY MICHIGAN STATE BOARD OF LAND SURVEYORS, JAN. 28, 1971
REVISED MAY 14, 1975
REVISED JAN., 1983