

SURVEY & REMONUMENTATION

LIBER 15212 PG. 870

JAN 20 95 011184

OK - T. SMITH

MAY - 1 1995

LAND CORNER RECORDATION CERTIFICATE

Filing Requirement of Act 74, Mich. P.A. 1970

\$ 7.00 MISCELLANEOUS RECORDING
 \$ 2.00 REMONUMENTATION
 20 JAN 95 7:32 A.M. RECEIPT# 78
 PAID RECORDED - OAKLAND COUNTY
 LYNN D. ALLEN, CLERK/REGISTER OF DEEDS

For corners in **COMMISSION**
 Oakland
(County)

Located In: Orion
 Twp. Corner Code #

- | | | | | | |
|------------------------------------|---|----|---|-----|------|
| 1. Public Land Survey | T | 4N | R | 10E | J-13 |
| | T | | R | | |
| | T | | R | | |
| | T | | R | | |
| 2. Property Controlling in Section | S | | T | R | |
| | S | | T | R | |
| 3. Miscellaneous Property in Sec. | S | | T | R | |
| | S | | T | R | |
4. Lot No. _____, Recorded Plat _____
 5. Private Claims _____

Compliance with ACT 345, P.A. 1990

APPROVED ON: 12-29-94
 OAKLAND COUNTY REMONUMENTATION
 PEER GROUP COMMITTEE
 Register of Deeds Stamp & File Number

I, Huston K. Kennedy, in a field survey on December 17, 19 94, do hereby certify that under requirements of P.A. 74, Michigan P.A. of 1970, the corner points mentioned in lines 1 and 2 above were in conformance with regulations and rules therefore as required in the current manual of survey instructions of the United States Department of the Interior, Bureau of Land Management or by a decree of a Court of Law and/or that the corner points mentioned in lines 3, 4 and 5 above were in conformance with the rules of the Michigan Board of Land Surveyors or by a Decree of a Court of Law; established, re-established, monumented, re-monumented, recovered, found as expressed below:

A	B	C	D	E	F	G	H	I	J	K	L
2	6	5	4	3	2	1					
3											
4	7	8	9	10	11	12					
5											
6	18	17	16	15	14	13					
7											
8	19	20	21	22	23	24					
9											
10	30	29	28	27	26	25					
11											
12	31	32	33	34	35	36					
13											

NOTE: Not more than 4 corners, all in the same town and range, may be recorded on this certificate.

A. Description of original monument and accessories and/or subsequent restoration:

- 1817-GLO Wampler, D.S.; Set Post 30" White Oak N61°E 18 Links; 4" White Oak S24°E 38 Links
- 1986-Kennedy, PS #17623; LCRC L.9397, Pg.258 - Fnd 1/2" Iron Rod
 - 1988-Buckerfield, PS #10868; LCRC L.10692, Pg.555 - Fnd Capped Iron
 - 1990-Buckerfield, PS #10868; LCRC L.11262, Pg.072 - Fnd Capped Iron, used same wit as 1988 LCRC
 - 1983-Kennedy, PS #17623; Unrecorded Survey - Set 1/2" Iron Rod.
 - 1983-Kennedy, PS #17623; Unrecorded Survey - Fnd 1/2" Iron Rod, used same wit as 1983 Unrecorded Survey
 - 1983-Kennedy, PS #17623; Unrecorded Survey - Fnd 1/2" Iron Rod, used same wit as 1983 Unrecorded Survey
 - 1986-Kennedy, PS #17623; Unrecorded Survey - Fnd 1/2" Iron Rod, used same wit as 1983 Unrecorded Survey
 - 1986-Kennedy, PS #17623; Unrecorded Survey - Fnd 1/2" Iron Rod, used same wit as 1983 Unrecorded Survey
 - 1987-Kennedy, PS #17623; Unrecorded Survey - Fnd 1/2" Iron Rod, used same wit as 1983 Unrecorded Survey

B. Description of corner evidence found and/or method applied in restoring or reestablishing corner:

1994 Kennedy Surveying, Inc. - Kennedy, PS #17623 - Fnd 1/2" Iron Rod w/cap #17623 on front slope for M-24 Highway, East of the North bound lanes on M-24 Highway and Brown extending to the West. Also found fence-tree line extending to the East.

Witnesses from LCRC #2 were used to recover and verify the location of the found 1/2" Iron Rod w/cap #17623.

I accepted the found 1/2" Iron Rod with cap #17623 as the best evidence of the original corner position.


FIELD MEASUREMENTS BETWEEN

- J-13 to K-13 2612.23 Ft. (H. Kennedy 1992)
- J-13 to I-13 2632.74 Ft. (H. Kennedy 1982)
- J-13 to J-12 3123.87 Ft. (H. Kennedy 1982)
- J-13 to I-1 2783.20 Ft. (M.D.O.T. 1954)

C. Description of monument for corner and accessories established to perpetuate locating the position of the corner:

J-13 I replaced the found 1/2" Iron Rod with a 1/2" Iron Rod encased in a 4" diameter concrete cylinder stamped Oakland County Remonumentation, PS #17623.
 N06°W 51.78' Set PK & Remon. Washer East face Power Pole
 Due West 9.58' Set PK & Remon. Washer North side Guard Rail Post
 S43°W 16.31' Set PK & Remon. Washer SE side Guard Rail Post
 S31°E 42.90' Set PK & Remon. Washer NE face 9" Poplar

The selected location is accepted by me and is generally accepted by Professional Surveyors as the best position of the original corner.

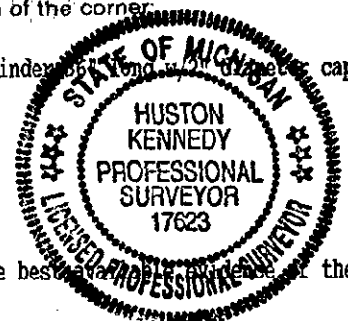

Signed by Huston K. Kennedy

Date January 5, 1995

Surveyor's Michigan License No. 17623