

MICHIGAN
DEPARTMENT OF CONSERVATION
FORESTRY DIVISION

(1)

LAND CORNER RECORD

T. 4 N.R. 11 E
T. 5 N.R. 11 E


Oakland COUNTY

DESCRIPTION OF CORNER Iron Pin set by other

CORNER MONUMENT Sec 31, 32 T 5 N - R 11 E 1/2 Sec 5, 6 T 4 N, R 11 E

DATE MONUMENT PLACED AND WITNESSED Recovered Jan 18, 1967

WITNESSES TO CORNER..... N 55° W 7.5' 8" oak

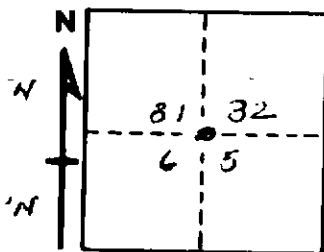

N 63° E 23.7' 6" oak


S 30° E 21.7' 15" oak

AND

CIRCLE CORNER REGISTERED

DESCRIPTION IN DETAIL AS TO HOW CORNER WAS LOCATED AND IDENTIFIED OR RESTORED.

Recovered from old Prop. Survey Plans

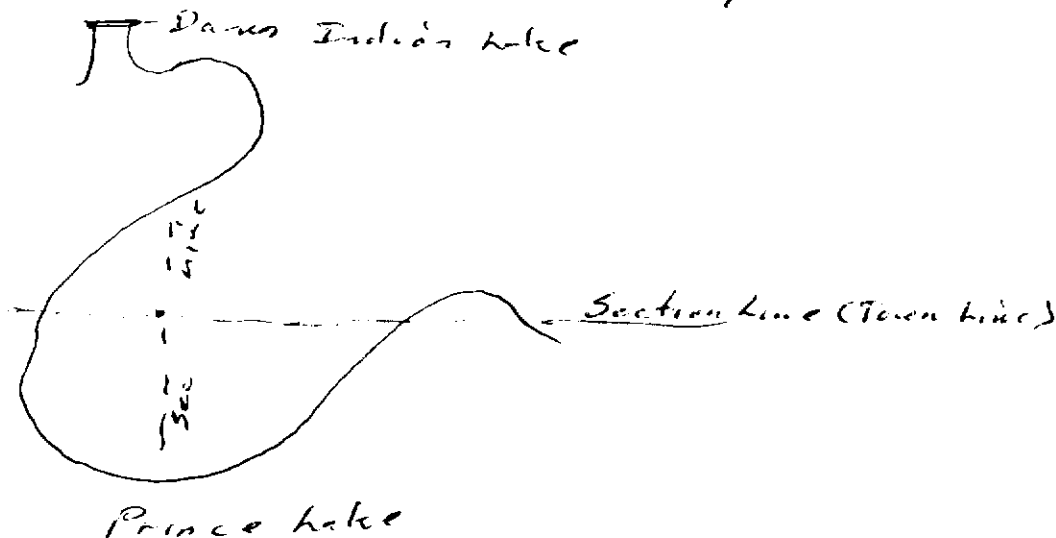

SURVEYOR'S SEAL

SIGNED _____ DATE _____

REGISTERED LAND SURVEYOR