

SURVEY & REMONUMENTATION

MAY - 1 1995

LISEP. 15212 PG 880

JAN 20 95 011194

93-1010
For corners in

COMMISSION

LAND CORNER RECORDATION CERTIFICATE
Filing Requirement of Act 74, Mich. P.A. 1970

9.00 MISCELLANEOUS RECORDING
2.00 REMONUMENTATION

20 JAN 95 7:36 A.M. RECEIPT# 9B
PAID RECORDED - OAKLAND COUNTY
LYNN D. ALLEN, CLERK/REGISTER OF DEEDS

OK - T. SMITH

Compliance with
ACT 345, P.A. 1990

APPROVED ON: 12-28-94
OAKLAND COUNTY REMONUMENTATION
PEER GROUP COMMITTEE
Register of Deeds Stamp & File Number

Oakland (County) Located in: Oakland Corner Code #

1. Public Land Survey	T	<u>4N</u>	R	<u>11E</u>	<u>A-4</u>
	T		R		
	T		R		
	T		R		
2. Property Controlling in Section	S		T		R
	S		T		R
3. Miscellaneous Property in Sec.	S		T		R
	S		T		R

4. Lot No. _____, Recorded Plat _____
5. Private Claims _____

I, Grant J. Ward, RLS in a field survey on March 7, 19 94, do hereby certify that under requirements of P.A. 74, Michigan P.A. of 1970, the corner points mentioned in lines 1 and 2 above were in conformance with regulations and rules therefore as required in the current manual of survey instructions of the United States Department of the Interior, Bureau of Land Management or by a decree of a Court of Law and/or that the corner points mentioned in lines 3, 4 and 5 above were in conformance with the rules of the Michigan Board of Land Surveyors or by a Decree of a Court of Law; established, re-established, monumented, re-monumented, recovered, found as expressed below:

NOTE: Not more than 4 corners, all in the same town and range, may be recorded on this certificate.

A. Description of original monument and accessories and/or subsequent restoration:

A-4 None, not set per G.L.O. Notes.

A	B	C	D	E	F	G	H	I	J	K	L
2	6	5	4	3	2	1					
3											
4	7	8	9	10	11	12					
5											
6	18	17	16	15	14	13					
7											
8	19	20	21	22	23	24					
9											
10	30	29	28	27	26	25					
11											
12	31	32	33	34	35	36					
13											

Handwritten signature and "file" note

B. Description of corner evidence found and/or method applied in restoring or reestablishing corner:

A-4 Corner common to Sec. 7 and Range Line, T. 4 N., R. 11 E. Found 1/2" Iron Rod in Monument Box, 2.5' South of Centerline of Stoney Creek Road. This corner location, although not established by an original government survey, is accepted as the best available evidence of the position of the corner.


Previously Recorded in L. 9856, P. 168 (M-4 of Orion Twp.) (3) of Oakland County Records.

(n) Indicates the number of references that confirms this corner by dimensional tie.

C. Description of monument for corner and accessories established to perpetuate locating the position of the corner:

A-4 Corner common to Sec. 7 and Range Line, T. 4 N., R. 11 E. Found Brass Remonumentation Disc #17623 in Monument Box (12-26-94).

- S. 77° E. 103.45' Set P.K. Nail & Brass Disc #22445 in SW. face of 6" Locust.
- N. 29° E. 45.03' Set P.K. Nail & Brass Disc #22445 in SE. face of 8" Locust.
- N. 33° W. 33.82' Set P.K. Nail & Brass Disc #22445 in SW. face of 10" Locust.
- Due South 33.40' Found 1/2" Iron Rod.

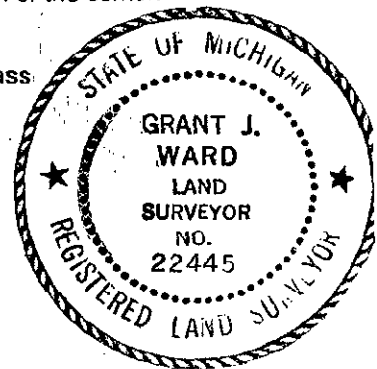

Signed by [Signature]

Date December 27, 1994

Surveyor's Michigan License No. 22445

93-1010