

SURVEY & REMONUMENTATION

JAN 20 95 011195

MAY - 1 1995

LIST# 15212 PG 882

OK - T. SMITH

93-1010
For corners in

COMMISSION

LAND CORNER RECORDATION CERTIFICATE

Filing Requirement of Act 74, Mich. P.A. 1970 § 9.00

MISCELLANEOUS RECORDING

Oakland
(County)

Located In: Oakland Corner Code =#

- | | | | | | |
|------------------------------------|---|-----------|---|------------|------------|
| 1. Public Land Survey | T | <u>4N</u> | R | <u>11E</u> | <u>A-5</u> |
| | T | _____ | R | _____ | _____ |
| | T | _____ | R | _____ | _____ |
| | T | _____ | R | _____ | _____ |
| 2. Property Controlling in Section | S | _____ | T | _____ | R |
| | S | _____ | T | _____ | R |
| 3. Miscellaneous Property in Sec. | S | _____ | T | _____ | R |
| | S | _____ | T | _____ | R |

4. Lot No. _____, Recorded Plat _____

5. Private Claims _____

I, Grant J. Ward, RLS in a field survey on December 23, 1994, do hereby certify that under requirements of P.A. 74, Michigan P.A. of 1970, the corner points mentioned in lines 1 and 2 above were in conformance with regulations and rules therefore as required in the current manual of survey instructions of the United States Department of the Interior, Bureau of Land Management or by a decree of a Court of Law and/or that the corner points mentioned in lines 3, 4 and 5 above were in conformance with the rules of the Michigan Board of Land Surveyors or by a Decree of a Court of Law; established, re-established, monumented, re-monumented, recovered, found as expressed below:

NOTE: Not more than 4 corners, all in the same town and range, may be recorded on this certificate.

A. Description of original monument and accessories and/or subsequent restoration:

A-5 Post, per G.L.O. Notes.

B. Description of corner evidence found and/or method applied in restoring or reestablishing corner:

A-5 Corner common to Sec. 7, 18 and Range Line, T. 4 N., R. 11 E. Found Pinch Pipe 0.3' above the ground surface. Fence to the North and East. This corner location is accepted as the best available evidence of the position of the corner.

Previously Recorded in L. 7177, P. 614 (M-5 of Orion Twp.) (3) of Oakland County Records.

(n) Indicates the number of references that confirms this corner by dimensional tie.


C. Description of monument for corner and accessories established to perpetuate locating the position of the corner:

A-5 Corner common to Sec. 7, 18 and Range Line, T. 4 N., R. 11 E. Found Remonumentation Monument and Brass Cap #17623 (11-23-94).

- S. 27° E. 28.46' Set P.K. Nail & Brass Disc #22445 in NE. face of 18" Cherry.
- N. 53° E. 14.16' Set P.K. Nail & Brass Disc #22445 in NW. face of 5" Maple.
- N. 57° W. 21.17' Set P.K. Nail & Brass Disc #22445 in SW. face of 16" Locust.
- S. 78° W. 24.73' Set P.K. Nail & Brass Disc #22445 in N. face of 16" Oak.
- Due West 46.71' Found Pinch Pipe.

	A	B	C	D	E	F	G	H	I	J	K	L
2	6		5		4		3		2		1	
3												
4	7		8		9		10		11		12	
5												
6	13		17		16		15		14		13	
7												
8	19		20		21		22		23		24	
9												
10	30		29		28		27		26		25	
11												
12	31		32		33		34		35		36	
13												

File

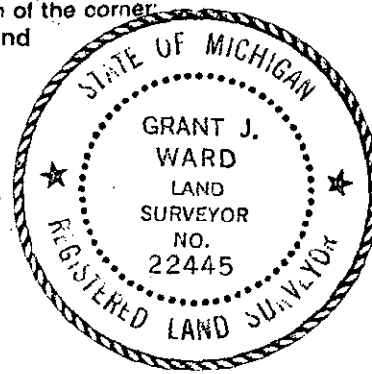

Signed by [Signature]
Surveyor's Michigan License No. 22445

Date December 30, 1994