

**SURVEY &  
REMONUMENTATION**

LIBER 15212 PG 884

JAN 20 95 011196

MAY - 1 1995

**LAND CORNER RECORDATION CERTIFICATE**

OK - T. SMITH

93-1010  
For corners in

**COMMISSION** Filing Requirement of Act 74, Mich. P.A. 1970

\$ 9.00 MISCELLANEOUS RECORDING  
\$ 2.00 REMONUMENTATION  
20 JAN 95 7:36 A.M. RECEIPT# 98  
PAID RECORDED - OAKLAND COUNTY  
LYNN D. ALLEN, CLERK/REGISTER OF DEEDS

Oakland  
(County)

Located In: Oakland Corner Code #

1. Public Land Survey	T	<u>4</u> N	R	<u>11</u> E	<u>A-6</u>
	T		R		
	T		R		
	T		R		
2. Property Controlling in Section	S		T		R
	S		T		R
3. Miscellaneous Property in Sec.	S		T		R
	S		T		R

Compliance with  
ACT 345, P.A. 1990

APPROVED ON: 12-29-94  
OAKLAND COUNTY REMONUMENTATION  
PEER GROUP COMMITTEE  
Register of Deeds Stamp & File Number

4. Lot No. \_\_\_\_\_, Recorded Plat \_\_\_\_\_  
5. Private Claims \_\_\_\_\_

I, Grant J. Ward, RLS, in a field survey on March 30, 19 94, do hereby certify that under requirements of P.A. 74, Michigan P.A. of 1970, the corner points mentioned in lines 1 and 2 above were in conformance with regulations and rules therefore as required in the current manual of survey instructions of the United States Department of the Interior, Bureau of Land Management or by a decree of a Court of Law and/or that the corner points mentioned in lines 3, 4 and 5 above were in conformance with the rules of the Michigan Board of Land Surveyors or by a Decree of a Court of Law, established, re-established, monumented, re-monumented, recovered, found as expressed below:

**NOTE: Not more than 4 corners, all in the same town and range, may be recorded on this certificate.**

A. Description of original monument and accessories and/or subsequent restoration:

A-6 None, not set per G.L.O. Notes.

B. Description of corner evidence found and/or method applied in restoring or reestablishing corner:

A-6 Corner common to Sec. 18 and Range Line, T. 4 N., R. 11 E. Found 3/4" Iron Pipe 1.7' West of the Centerline of Kern Road, 0.15' below Road surface. Fence to the East. This corner location, although not established by an original government survey, is accepted as the best available evidence of the position of the corner.

Previously Recorded in L. 6965, P. 91 (2) of Oakland County Records.

(n) Indicates the number of references that confirms this corner by dimensional tie.


C. Description of monument for corner and accessories established to perpetuate locating the position of the corner:

A-6 Corner common to Sec. 17 and Range Line, T. 4 N., R. 11 E. Set Iron Rod and Brass Cap #22445 adjoining Found 3/4" Iron Pipe.

- N. 56° E. 26.69' Set P.K. Nail & Brass Disc #22445 in S. face of 20" Cherry.
- S. 77° E. 24.53' Set P.K. Nail & Brass Disc #22445 in N. face of 12" Oak.
- S. 26° W. 39.63' Set P.K. Nail & Brass Disc #22445 in W. face of 6" & 8" Ash.
- N. 30° W. 37.31' Set P.K. Nail & Brass Disc #22445 in SW. face of 14" Poplar.
- Due South 77.20' Found 3/4" Iron Pipe.

A	B	C	D	E	F	G	H	I	J	K	L
2	6	6	4	3	2	1					
3											
4	7	8	9	10	11	12					
5											
6	18	17	16	15	14	13					
7											
8	19	20	21	22	23	24					
9											
10	30	29	28	27	26	25					
11											
12	31	32	33	34	35	36					
13											

*File*

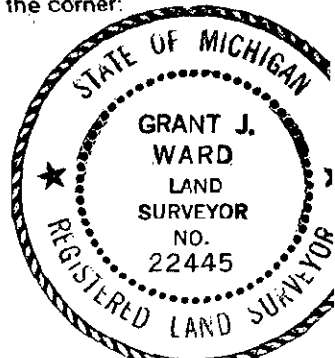

Signed by [Signature]  
Surveyor's Michigan License No. 22445

Date December 27, 1994