

SURVEY & REMONUMENTATION

JAN 20 9 11 197

MAY - 1 1995

LIBER 15212 PG 886

COMMISSION LAND CORNER RECORDATION CERTIFICATE

OK - T. SMITH
9.00 MISCELLANEOUS RECORDING

93-1010

For corners in

Oakland

(County)

Filing Requirement of Act 74, Mich. P.A. 1970

Located in: Oakland Corner Code #

2.00 REMONUMENTATION
20 JAN 95 7:36 A.M. RECEIPT# 9B
PAID RECORDED - OAKLAND COUNTY
LYNN D. ALLEN, CLERK/REGISTER OF DEEDS

1. Public Land Survey	T	4N	R	11E	A-7
	T		R		
	T		R		
	T		R		
2. Property Controlling in Section	S		T	R	
	S		T	R	
3. Miscellaneous Property in Sec.	S		T	R	
	S		T	R	

Compliance with ACT 345, P.A. 1990

APPROVED ON: 12-29-94
OAKLAND COUNTY REMONUMENTATION PEER GROUP COMMITTEE
Register of Deeds Stamp & File Number

4. Lot No. _____, Recorded Plat _____
5. Private Claims _____

I, Grant J. Ward, RLS, in a field survey on March 30, 19 94, do hereby certify that under requirements of P.A. 74, Michigan P.A. of 1970, the corner points mentioned in lines 1 and 2 above were in conformance with regulations and rules therefore as required in the current manual of survey instructions of the United States Department of the Interior, Bureau of Land Management or by a decree of a Court of Law and/or that the corner points mentioned in lines 3, 4 and 5 above were in conformance with the rules of the Michigan Board of Land Surveyors or by a Decree of a Court of Law; established, re-established, monumented, re-monumented, recovered, found as expressed below:

	A	B	C	D	E	F	G	H	I	J	K	L
2	6		5		4		3		2		1	
3												
4	7		8		9		10		11		12	
5												
6	18		17		16		15		14		13	
7												
8	19		20		21		22		23		24	
9												
10	30		29		28		27		26		25	
11												
12	31		32		33		34		35		36	
13												

NOTE: Not more than 4 corners, all in the same town and range, may be recorded on this certificate.

A. Description of original monument and accessories and/or subsequent restoration:

A-7 Post, per G.L.O. Notes.

B. Description of corner evidence found and/or method applied in restoring or reestablishing corner:

A-7 Corner common to Sec. 18, 19 and Range Line, T. 4 N., R. 11 E. Found 1" Iron Pipe 0.6' below Road surface, 2' West of the Centerline of Kern Road and 6' South of fence to the East. This corner location is accepted as the best available evidence of the position of the corner.


Previously Recorded in L. 6520, P. 114 (2) of Oakland County Records.

(n) Indicates the number of references that confirms this corner by dimensional tie.

C. Description of monument for corner and accessories established to perpetuate locating the position of the corner:

A-7 Corner common to Sec. 18, 19 and Range Line, T. 4 N., R. 11 E. Set Iron Rod and Brass Cap #22445 adjoining Found 1" Iron Pipe.

- N. 20° E. 83.79' Set P.K. Nail & Brass Disc #22445 in W. face of 16" Oak.
- N. 10° W. 86.08' Set P.K. Nail & Brass Disc #22445 in E. face of 38" Oak.
- N. 18° W. 62.66' Set P.K. Nail & Brass Disc #22445 in SW. face of 5" Elm.
- S. 47° W. 55.06' Set P.K. Nail & Brass Disc #22445 in SE. face of 5" Elm.

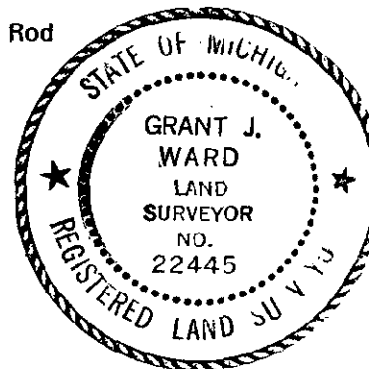

Signed by [Signature]

Date December 27, 1994

Surveyor's Michigan License No. 22445