

SURVEY & REMONUMENTATION

JAN 20 9 50 AM 1995

LIBER 15212 PG 888

MAY - 1 1995

OK - T. SMITH

93-1010
For corners in

COMMISSION LAND CORNER RECORDATION CERTIFICATE
Filing Requirement of Act 74, Mich. P.A. 1970

9.00 MISCELLANEOUS RECORDING
\$ 2.00 REMONUMENTATION
20 JAN 95 7:36 A.M. RECEIPT# 98
PAID RECORDED - OAKLAND COUNTY
LYNN D. ALLEN, CLERK/REGISTER OF DEEDS

Oakland Located In: Oakland Corner Code # _____
(County)

- | | | | | | |
|------------------------------------|---|-----------|---|------------|------------|
| 1. Public Land Survey | T | <u>4N</u> | R | <u>11E</u> | <u>A-8</u> |
| | T | _____ | R | _____ | _____ |
| | T | _____ | R | _____ | _____ |
| | T | _____ | R | _____ | _____ |
| 2. Property Controlling in Section | S | _____ | T | _____ | _____ |
| | S | _____ | T | _____ | _____ |
| 3. Miscellaneous Property in Sec. | S | _____ | T | _____ | _____ |
| | S | _____ | T | _____ | _____ |

Compliance with
ACT 345, P.A. 1990

APPROVED ON: 12-29-94
OAKLAND COUNTY REMONUMENTATION
PEER GROUP COMMITTEE
Register of Deeds Stamp & File Number

4. Lot No. _____, Recorded Plat _____
5. Private Claims _____

I, Grant J. Ward, RLS in a field survey on February 23, 19 94, do hereby certify that under requirements of P.A. 74, Michigan P.A. of 1970, the corner points mentioned in lines 1 and 2 above were in conformance with regulations and rules therefore as required in the current manual of survey instructions of the United States Department of the Interior, Bureau of Land Management or by a decree of a Court of Law and/or that the corner points mentioned in lines 3, 4 and 5 above were in conformance with the rules of the Michigan Board of Land Surveyors or by a Decree of a Court of Law; established, re-established, monumented, re-monumented, recovered, found as expressed below:

NOTE: Not more than 4 corners, all in the same town and range, may be recorded on this certificate.

A. Description of original monument and accessories and/or subsequent restoration:

A-8 None, not set according to G.L.O. Notes.

B. Description of corner evidence found and/or method applied in restoring or reestablishing corner:


A-8 Corner common to Sec. 19 and Range Line, T. 4 N., R. 11 E. Found 1/2" Iron Rod, 0.25' below Road surface. Iron is 4.5" West of the Centerline of Kern Road. Fence and tree line runs East. This corner location, although not established by an original government survey, is accepted as the best available evidence of the position of the corner.

Previously Unrecorded in Oakland County Records.

C. Description of monument for corner and accessories established to perpetuate locating the position of the corner:

A-8 Corner common to Sec. 19 and Range Line, T. 4 N., R. 11 E. Set 5/8" Iron Rod and Brass Cap #22445 adjoining Found 1/2" Iron Rod.

- | | | |
|-----------|--------|---|
| Due West | 12.83' | Set P.K. Nail & Brass Disc #22445 in N. face of 6x6 wood post. |
| N. 32° W. | 40.99' | Set P.K. Nail & Brass Disc #22445 in SW. face of 8" & 5" Elm. |
| N. 10° W. | 84.59' | Set P.K. Nail & Brass Disc #22445 in W. face of triple 10" Ash. |
| N. 26° E. | 57.88' | Set P.K. Nail & Brass Disc #22445 in W. face of 16" Oak. |

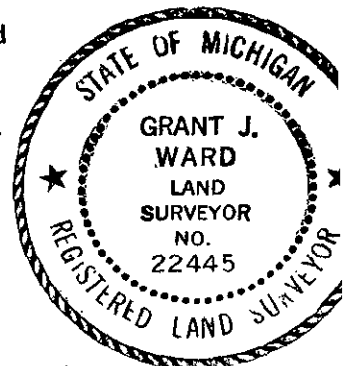

Signed by [Signature] Date December 27, 1994
Surveyor's Michigan License No. 22445

	A	B	C	D	E	F	G	H	I	J	K	L
2	6	5	4	3	2	1						
3												
4	7	8	9	10	11	12						
5												
6	18	17	16	15	14	13						
7												
8	19	20	21	22	23	24						
9												
10	30	29	28	27	26	25						
11												
12	31	32	33	34	35	36						
13												

[Handwritten initials]