

**SURVEY &
REMONUMENTATION**

LIBER **15212** PG **898**

Jan 20 95 011203

OK - T. SMITH

93-1010 MAY - 1 1995
For corners in **COMMISSION**
Oakland
(County)

LAND CORNER RECORDATION CERTIFICATE
Filing Requirement of Act 74, Mich. P.A. 1970

\$ 9.00 MISCELLANEOUS RECORDING
\$ 2.00 REMONUMENTATION
20 JAN 95 7:38 A.M. RECEIPT# 98
PAID RECORDED - OAKLAND COUNTY
LYNN D. ALLEN, CLERK/REGISTER OF DEEDS

Located In: Oakland Corner Code #

- | | | |
|------------------------------------|--------------------------|-------------|
| 1. Public Land Survey | T <u>4N</u> R <u>11E</u> | <u>A-13</u> |
| | T _____ R _____ | _____ |
| | T _____ R _____ | _____ |
| | T _____ R _____ | _____ |
| 2. Property Controlling in Section | S _____ T _____ R _____ | _____ |
| | S _____ T _____ R _____ | _____ |
| 3. Miscellaneous Property in Sec. | S _____ T _____ R _____ | _____ |
| | S _____ T _____ R _____ | _____ |

Compliance with ACT 345, P.A. 1990
APPROVED ON: 12-29-94
OAKLAND COUNTY REMONUMENTATION PEER GROUP COMMITTEE
Register of Deeds Stamp & File Number

4. Lot No. _____, Recorded Plat _____
5. Private Claims _____

	A	B	C	D	E	F	G	H	I	J	K	L
2	6		5		4		3		2		1	
3												
4	7		8		9		10		11		12	
5												
6	18		17		16		15		14		13	
7												
8	19		20		21		22		23		24	
9												
10	30		29		28		27		26		25	
11												
12	31		32		33		34		35		36	

I, Grant J. Ward, RLS, in a field survey on February 17, 19 94, do hereby certify that under requirements of P.A. 74, Michigan P.A. of 1970, the corner points mentioned in lines 1 and 2 above were in conformance with regulations and rules therefore as required in the current manual of survey instructions of the United States Department of the Interior, Bureau of Land Management or by a decree of a Court of Law and/or that the corner points mentioned in lines 3, 4 and 5 above were in conformance with the rules of the Michigan Board of Land Surveyors or by a Decree of a Court of Law, established, re-established, monumented, re-monumented, recovered, found as expressed below:

NOTE: Not more than 4 corners, all in the same town and range, may be recorded on this certificate.

A. Description of original monument and accessories and/or subsequent restoration:

A-13 Post, per G.L.O. Notes.

2200 file

B. Description of corner evidence found and/or method applied in restoring or reestablishing corner:

A-13 Corner common to Sec. 31, Range Line and Town Line, T. 4 N., R. 11 E. Dutton Road under construction. Set 3/4" Iron Rod and Brass Cap #22445 using old references in the Centerline of Dutton Road and 0.15' below Road surface. This corner location is accepted as a careful and faithful perpetuation of the position of the original corner.


Previously Recorded in L. 11476, P. 481 (2) of Oakland County Records.
Previously Recorded in L. 12560, P. 588 (M-13 in Orion Twp.) (3) of Oakland County Records.
Previously Recorded in L. 7283, P. 220 (A-1 in Avon Twp.) (1) of Oakland County Records.

(n) Indicates the number of references that confirms this corner by dimensional tie.

C. Description of monument for corner and accessories established to perpetuate locating the position of the corner:

A-13 Corner common to Sec. 31, Range Line and Town Line, T. 4 N., R. 11 E. Set Brass Cap #22445 in Monument Box.

- N. 67° E. 58.34' Set P.K. Nail & Brass Disc #22445 in NW. face of 16" Walnut.
- N. 10° E. 26.66' Set P.K. Nail & Brass Disc #22445 in W. face of 30" Oak.
- S. 75° W. 72.15' Set P.K. Nail & Brass Disc #22445 in NW. face of 12" Cedar.
- Due South 43.86' Set P.K. Nail & Brass Disc #22445 in E. face of Light Pole.
- S. 04° E. 33.16' Found "T" Iron.

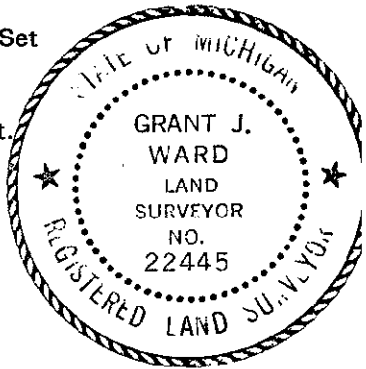

Signed by [Signature] Date December 30, 1994

Surveyor's Michigan License No. 22445

93-1010