

SURVEY & REMONUMENTATION

LIBER 15212 PG 900

JAN 20 95 011204
OK - T. SMITH

MAY - 1 1995

LAND CORNER RECORDATION CERTIFICATE

93-1010
For corners in
Oakland
(County)

COMMISSION

Filing Requirement of Act 74, Mich. P.A. 1970 9.00

MISCELLANEOUS RECORDING

\$ 2.00 REMONUMENTATION
20 JAN 95 7:38 A.M. RECEIPT# 9B
PAID RECORDED - OAKLAND COUNTY
LYNN D. ALLEN, CLERK/REGISTER OF DEEDS

Located In: Oakland Corner Code #

- 1. Public Land Survey T 4N R 11E B-5
T _____ R _____
T _____ R _____
T _____ R _____
- 2. Property Controlling S _____ T _____ R _____
in Section S _____ T _____ R _____
- 3. Miscellaneous S _____ T _____ R _____
Property in Sec. S _____ T _____ R _____

Compliance with ACT 345, P.A. 1990

APPROVED ON: 12-28-94
OAKLAND COUNTY REMONUMENTATION
PEER GROUP COMMITTEE

Register of Deeds Stamp & File Number

- 4. Lot No. _____, Recorded Plat _____
- 5. Private Claims _____

I, Grant J. Ward, RLS in a field survey on November 23, 19 94, do hereby certify that under requirements of P.A. 74, Michigan P.A. of 1970, the corner points mentioned in lines 1 and 2 above were in conformance with regulations and rules therefore as required in the current manual of survey instructions of the United States Department of the Interior, Bureau of Land Management or by a decree of a Court of Law and/or that the corner points mentioned in lines 3, 4 and 5 above were in conformance with the rules of the Michigan Board of Land Surveyors or by a Decree of a Court of Law; established, re-established, monumented, re-monumented, recovered, found as expressed below:

NOTE: Not more than 4 corners, all in the same town and range, may be recorded on this certificate.

| | | | | | | | | | | | | | |
|----|----|----|----|----|----|----|---|---|---|---|---|---|---|
| | A | B | C | D | E | F | G | H | I | J | K | L | I |
| 2 | 6 | 5 | 4 | 3 | 2 | 1 | | | | | | | |
| 3 | | | | | | | | | | | | | |
| 4 | 7 | 8 | 9 | 10 | 11 | 12 | | | | | | | |
| 5 | ● | | | | | | | | | | | | |
| 6 | 18 | 17 | 16 | 15 | 14 | 13 | | | | | | | |
| 7 | | | | | | | | | | | | | |
| 8 | 19 | 20 | 21 | 22 | 23 | 24 | | | | | | | |
| 9 | | | | | | | | | | | | | |
| 10 | 30 | 29 | 28 | 27 | 26 | 25 | | | | | | | |
| 11 | | | | | | | | | | | | | |
| 12 | 31 | 32 | 33 | 34 | 35 | 36 | | | | | | | |
| 13 | | | | | | | | | | | | | |

A. Description of original monument and accessories and/or subsequent restoration:

B-5 Post, according to G.L.O. Notes.

*200
260
File*

B. Description of corner evidence found and/or method applied in restoring or reestablishing corner:

B-5 Corner common to Sec. 7 and 18, T. 4 N., R. 11 E. Found 1/2" Iron Rod 0.3' below Road surface, on the North edge of Clarkston Road. This corner location is accepted as the best available evidence of the position of the corner.


Previously Recorded in L. 8854, P. 257 (2) of Oakland County Records.

(n) Indicates the number of references that confirms this corner by dimensional tie.

C. Description of monument for corner and accessories established to perpetuate locating the position of the corner:

B-5 Corner common to Sec. 7 and 18, T. 4 N., R. 11 E. Set 5/8" Iron Rod and Brass Cap #22445 adjoining Found 1/2" Iron Rod.

- S. 32° W. 31.19' Set P.K. Nail & Brass Disc #22445 in E. face of twin 14" Elm.
- S. 69° W. 78.03' Set P.K. Nail & Brass Disc #22445 in N. face of 18" Oak.
- N. 20° W. 40.04' Set P.K. Nail & Brass Disc #22445 in E. face of 20" Elm.
- S. 50° E. 68.96' Set P.K. Nail & Brass Disc #22445 in N. face of 42" Oak.

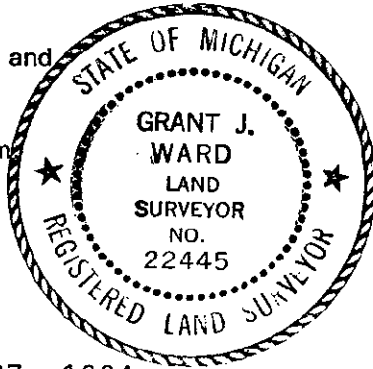

Signed by [Signature]
Surveyor's Michigan License No. 22445

Date December 27, 1994

93-1010