

**SURVEY &
REMONUMENTATION**

LIBER **15213** PG **001**

JAN 20 95 011205

MAY - 1 1995

OK - T. SMITH

93-1010
For corners in

LAND CORNER RECORDATION CERTIFICATE
COMMISSION Filing Requirement of Act 74, Mich. P.A. 1970

\$ 9.00 MISCELLANEOUS RECORDING
\$ 2.00 REMONUMENTATION
20 JAN 95 7:38 A.M. RECEIPT# 9B
PAID RECORDED - OAKLAND COUNTY
LYNN D. ALLEN, CLERK/REGISTER OF DEEDS

Oakland (County) Located In: Oakland Corner Code # B-7

1. Public Land Survey	T <u>4N</u> R <u>11E</u>	<u>B-7</u>
	T _____ R _____	_____
	T _____ R _____	_____
	T _____ R _____	_____
2. Property Controlling in Section	S _____ T _____ R _____	_____
	S _____ T _____ R _____	_____
3. Miscellaneous Property in Sec.	S _____ T _____ R _____	_____
	S _____ T _____ R _____	_____

4. Lot No. _____, Recorded Plat _____
5. Private Claims _____

Compliance with
ACT 345, P.A. 1990

APPROVED ON: 12-28-94
OAKLAND COUNTY REMONUMENTATION
PEER GROUP COMMITTEE
Register of Deeds Stamp & File Number

I, Grant J. Ward, RLS in a field survey on March 8, 19 94, do hereby certify that under requirements of P.A. 74, Michigan P.A. of 1970, the corner points mentioned in lines 1 and 2 above were in conformance with regulations and rules therefore as required in the current manual of survey instructions of the United States Department of the Interior, Bureau of Land Management or by a decree of a Court of Law and/or that the corner points mentioned in lines 3, 4 and 5 above were in conformance with the rules of the Michigan Board of Land Surveyors or by a Decree of a Court of Law; established, re-established, monumented, re-monumented, recovered, found as expressed below:

	A	B	C	D	E	F	G	H	I	J	K	L
2	6	5	4	3	2	1						
3												
4	7	8	9	10	11	12						
5												
6	18	17	16	15	14	13						
7	●											
8	19	20	21	22	23	24						
9												
10	30	29	28	27	26	25						
11												
12	31	32	33	34	35	36						
13												

NOTE: Not more than 4 corners, all in the same town and range, may be recorded on this certificate.

A. Description of original monument and accessories and/or subsequent restoration:

B-7 Post, per G.L.O. Notes.

*900
file*

B. Description of corner evidence found and/or method applied in restoring or reestablishing corner:


B-7 Corner common to Sec. 18 and 19, T. 4 N., R. 11 E. Found Monument at Intersection of North, East, South and West fences, 0.2' above ground surface. This corner location is a careful and faithful perpetuation of the position of the original corner.

Previously Unrecorded in Oakland County Records.

C. Description of monument for corner and accessories established to perpetuate locating the position of the corner:

B-7 Corner common to Sec. 18 and 19, T. 4 N., R. 11 E. Set Brass Cap #22445 on Found Monument.

- S. 80° E. 18.83' Set P.K. Nail & Brass Disc #22445 in SW. face of 12" Oak.
- N. 30° E. 18.94' Set P.K. Nail & Brass Disc #22445 in E. face of 14" Maple.
- N. 45° W. 21.03' Set P.K. Nail & Brass Disc #22445 in S. face of 16" Maple.
- S. 52° W. 18.51' Set P.K. Nail & Brass Disc #22445 in SE. face of 12" Maple.

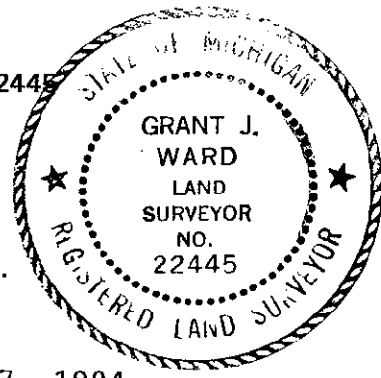

Signed by [Signature] Date December 27, 1994
Surveyor's Michigan License No. 22445