

SURVEY & REMONUMENTATION

JAN 20 95 011207

LIBER 15213 PC 005

MAY - 1 1995

OK - T. SMITH

93-1010
For corners in

LAND CORNER RECORDATION CERTIFICATE
Filing Requirement of Act 74, Mich. P.A. 1970

\$ 9.00 MISCELLANEOUS RECORDING
\$ 2.00 REMONUMENTATION
20 JAN 95 7:40 A.M. RECEIPT# 10B
PAID RECORDED - OAKLAND COUNTY
LYNN D. ALLEN, CLERK/REGISTER OF DEEDS

Oakland Located In: Oakland Corner Code #

1. Public Land Survey	T	<u>4N</u>	R	<u>11E</u>	<u>B-11</u>
	T		R		
	T		R		
	T		R		
2. Property Controlling in Section	S		T	R	
	S		T	R	
3. Miscellaneous Property in Sec.	S		T	R	
	S		T	R	

Compliance with
ACT 345, P.A. 1990

APPROVED ON: 12-29-94
OAKLAND COUNTY REMONUMENTATION
PEER GROUP COMMITTEE
Register of Deeds Stamp & File Number

4. Lot No. _____, Recorded Plat _____
5. Private Claims _____

I, Grant J. Ward, RLS, in a field survey on December 29, 1994, do hereby certify that under requirements of P.A. 74, Michigan P.A. of 1970, the corner points mentioned in lines 1 and 2 above were in conformance with regulations and rules therefore as required in the current manual of survey instructions of the United States Department of the Interior, Bureau of Land Management or by a decree of a Court of Law and/or that the corner points mentioned in lines 3, 4 and 5 above were in conformance with the rules of the Michigan Board of Land Surveyors or by a Decree of a Court of Law; established, re-established, monumented, re-monumented, recovered, found as expressed below:

A	B	C	D	E	F	G	H	I	J	K	L
2	6	5	4	3	2	1					
3											
4	7	8	9	10	11	12					
5											
6	18	17	16	15	14	13					
7											
8	19	20	21	22	23	24					
9											
10	30	29	28	27	26	25					
11	●										
12	31	32	33	34	35	36					

NOTE: Not more than 4 corners, all in the same town and range, may be recorded on this certificate.

A. Description of original monument and accessories and/or subsequent restoration:

B-11 Post, per G.L.O. Notes.

Handwritten initials/signature

B. Description of corner evidence found and/or method applied in restoring or reestablishing corner:


B-11 Corner common to Sec. 30 and 31, T. 4 N., R. 11 E. Found 1" Square Iron Rod in Monument Box, 0.2' below Road surface and 0.85' South of the Centerline of Silver Bell Road. This corner location is a careful and faithful perpetuation of the position of the original corner.

Previously Unrecorded in Oakland County Records.

C. Description of monument for corner and accessories established to perpetuate locating the position of the corner:

B-11 Corner common to Sec. 30 and 31, T. 4 N., R. 11 E. Set 5/8" Iron Rod and Brass Cap #22445 in place of 1" Square Iron Rod in Monument Box.

- N. 45° E. 46.36' Set P.K. Nail & Brass Disc #22445 in SE. face of 10" Elm.
- S. 45° E. 36.74' Set P.K. Nail & Brass Disc #22445 in NE. face of 10" Elm.
- S. 38° W. 33.06' Set P.K. Nail & Brass Disc #22445 in SE. face of 8" Elm.
- N. 59° W. 90.89' Set P.K. Nail & Brass Disc #22445 in SW. face of 12" Elm.
- N. 02° W. 59.98' Found Iron Rod.

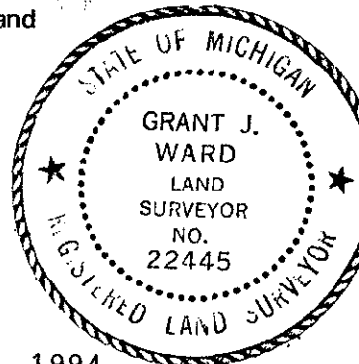

Signed by [Signature]

Date December 30, 1994

Surveyor's Michigan License No 22445