

SURVEY & REMONUMENTATION

LIBER 15213 PG 007

JAN 20 95 01 12 08
OK - T. SMITH

MAY - 1 1995

LAND CORNER RECORDATION CERTIFICATE

\$ 9.00 MISCELLANEOUS RECORDING
\$ 2.00 REMONUMENTATION

20 JAN 95 7:40 A.M. RECEIPT# 10B
PAID RECORDED - OAKLAND COUNTY
LYNN D. ALLEN, CLERK/REGISTER OF DEEDS

93-1010
For corners in
Oakland
(County)

COMMISSION

Filing Requirement of Act 74, Mich. P.A. 1970

Located In: Oakland Corner Code #

- | | | | | | |
|------------------------------------|---|-----------|---|------------|-------------|
| 1. Public Land Survey | T | <u>4N</u> | R | <u>11E</u> | <u>B-13</u> |
| | T | | R | | |
| | T | | R | | |
| | T | | R | | |
| 2. Property Controlling in Section | S | | T | R | |
| | S | | T | R | |
| 3. Miscellaneous Property in Sec. | S | | T | R | |
| | S | | T | R | |

Compliance with
ACT 345, P.A. 1990

APPROVED ON: 12-28-94
OAKLAND COUNTY REMONUMENTATION
PEER GROUP COMMITTEE
Register of Deeds Stamp & File Number

4. Lot No. _____, Recorded Plat _____
5. Private Claims _____

	A	B	C	D	E	F	G	H	I	J	K	L
2	6		5		4		3		2		1	
3												
4	7		8		9		10		11		12	
5												
6	18		17		16		15		14		13	
7												
8	19		20		21		22		23		24	
9												
10	30		29		28		27		26		25	
11												
12	31		32		33		34		35		36	
13												

I, Grant J. Ward, RLS, in a field survey on February 17, 1994, do hereby certify that under requirements of P.A. 74, Michigan P.A. of 1970, the corner points mentioned in lines 1 and 2 above were in conformance with regulations and rules therefore as required in the current manual of survey instructions of the United States Department of the Interior, Bureau of Land Management or by a decree of a Court of Law and/or that the corner points mentioned in lines 3, 4 and 5 above were in conformance with the rules of the Michigan Board of Land Surveyors or by a Decree of a Court of Law, established, re-established, monumented, re-monumented, recovered, found as expressed below:

NOTE: Not more than 4 corners, all in the same town and range, may be recorded on this certificate.

A. Description of original monument and accessories and/or subsequent restoration:

B-13 Post, per G.L.O. Notes.

B. Description of corner evidence found and/or method applied in restoring or reestablishing corner:

B-13 Corner common to Sec. 31 and the Town Line, T. 4 N., R. 11 E. Found Iron Rod and Cap #15066 in Monument Box, 1.15' below Road surface, 0.65' North of the Centerline of Dutton Road. This corner location is a careful and faithful perpetuation of the position of the original corner.

Previously Recorded in L. 11476, P. 480 (1) of Oakland County Records.


Previously Recorded in L. 6025, P. 559 (B-1 in Avon Twp.) (1); and L. 7177, P. 586 (B-1 in Avon Twp.) (0) of Oakland County Records.

(n) Indicates the number of references that confirms this corner by dimensional tie.

C. Description of monument for corner and accessories established to perpetuate locating the position of the corner:

B-13 Corner common to Sec. 31 and the Town Line, T. 4 N., R. 11 E. Set Iron Rod and Brass Cap #22445 adjoining Found Iron Rod and Cap #15066 in Monument Box.

- N. 26° E. 52.07' Set P.K. Nail & Brass Disc #22445 in NW. face of Utility Pole.
- S. 04° W. 73.77' Set P.K. Nail & Brass Disc #22445 in twin 6" Maple.
- S. 71° W. 85.39' Set P.K. Nail & Brass Disc #22445 in SE. face of 4" Box Elder.
- N. 64° W. 130.60' Southeast corner of Brick "Musson Elementary" School Sign.
- S. 02° E. 59.95' Found Iron Rod.

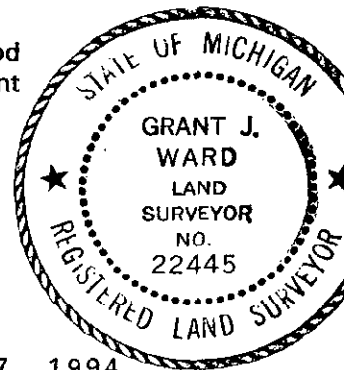

Signed by [Signature]
Surveyor's Michigan License No. 22445

Date December 27, 1994

93-1010