

**SURVEY &
REMONUMENTATION**

JAN 20 1995 11 21 10

LIBER **15213** PC **011**

MAY - 1 1995

LAND CORNER RECORDATION CERTIFICATE

OK - T. SMITH

93-1010
For corners in

COMMISSION Filing Requirement of Act 74, Mich. P.A. 1974 9.00 MISCELLANEOUS RECORDING

Oakland
(County)

Located in: Oakland Corner Code #

\$ 2.00 REMONUMENTATION
20 JAN 95 7:41 A.M. RECEIPT# 10B
PAID RECORDED - OAKLAND COUNTY
LYNN D. ALLEN, CLERK/REGISTER OF DEEDS

Compliance with
ACT 345, P.A. 1990

APPROVED ON: 12-28-94
OAKLAND COUNTY REMONUMENTATION
PEER GROUP COMMITTEE
Register of Deeds Stamp & File Number

| | | | | | |
|------------------------------------|---|------------|---|-------------|-------|
| 1. Public Land Survey | T | <u>4</u> N | R | <u>11</u> E | C-5 |
| | T | _____ | R | _____ | _____ |
| | T | _____ | R | _____ | _____ |
| | T | _____ | R | _____ | _____ |
| 2. Property Controlling in Section | S | _____ | T | _____ | R |
| | S | _____ | T | _____ | R |
| 3. Miscellaneous Property in Sec. | S | _____ | T | _____ | R |
| | S | _____ | T | _____ | R |

4. Lot No. _____, Recorded Plat _____
5. Private Claims _____

| | | | | | | | | | | | | |
|----|----|----|----|----|----|----|---|---|---|---|---|---|
| | A | B | C | D | E | F | G | H | I | J | K | L |
| 2 | 6 | 5 | 4 | 3 | 2 | 1 | | | | | | |
| 3 | | | | | | | | | | | | |
| 4 | 7 | 8 | 9 | 10 | 11 | 12 | | | | | | |
| 5 | | | | | | | | | | | | |
| 6 | 18 | 17 | 16 | 15 | 14 | 13 | | | | | | |
| 7 | | | | | | | | | | | | |
| 8 | 19 | 20 | 21 | 22 | 23 | 24 | | | | | | |
| 9 | | | | | | | | | | | | |
| 10 | 30 | 29 | 28 | 27 | 26 | 25 | | | | | | |
| 11 | | | | | | | | | | | | |
| 12 | 31 | 32 | 33 | 34 | 35 | 36 | | | | | | |
| 13 | | | | | | | | | | | | |

I, Grant J. Ward, RLS, in a field survey on February 24, 19 94, do hereby certify that under requirements of P.A. 74, Michigan P.A. of 1970, the corner points mentioned in lines 1 and 2 above were in conformance with regulations and rules therefore as required in the current manual of survey instructions of the United States Department of the Interior, Bureau of Land Management or by a decree of a Court of Law and/or that the corner points mentioned in lines 3, 4 and 5 above were in conformance with the rules of the Michigan Board of Land Surveyors or by a Decree of a Court of Law; established, re-established, monumented, re-monumented, recovered, found as expressed below:

NOTE: Not more than 4 corners, all in the same town and range, may be recorded on this certificate.

A. Description of original monument and accessories and/or subsequent restoration:

C-5 Post, per G.L.O. Notes.

B. Description of corner evidence found and/or method applied in restoring or reestablishing corner:

C-5 Corner common to Sec. 7, 8, 17 and 18, T. 4 N., R. 11 E. Found 3" Disc in Monument Box in the Centerline/Centerline of Clarkston and Adams Roads. Disc is 0.3' below surface. This corner location is accepted as the best available evidence of the position of the corner.


Previously Recorded in L. 5960, P. 281 (1), L. 6965, P. 89 (1) and L. 9673, P. 254 (3) of Oakland County Records.

(n) Indicates the number of references that confirms this corner by dimensional tie.

C. Description of monument for corner and accessories established to perpetuate locating the position of the corner:

C-5 Corner common to Sec. 7, 8, 17 and 18, T. 4 N., R. 11 E. Found 3" Disc in Monument Box.

- N. 85° W. 52.31' Set P.K. Nail & Brass Disc #22445 in S. face of twin 18" Oak.
- S. 46° W. 61.23' Set P.K. Nail & Brass Disc #22445 in NE. face of 26" Oak.
- S. 79° E. 69.51' Set P.K. Nail & Brass Disc #22445 in N. face of 26" Walnut.
- N. 56° E. 52.80' Set P.K. Nail & Brass Disc #22445 in SE. face of 12" Walnut.

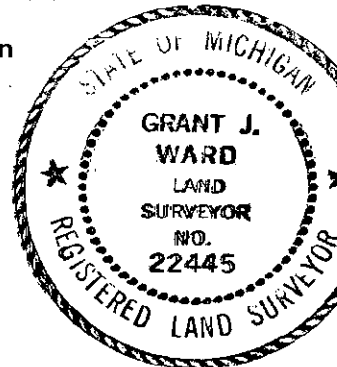

Signed by [Signature]
Surveyor's Michigan License No. 22445

Date December 27, 1994

93-1010