

JAN 20 95 11 21 1

SURVEY & REMONUMENTATION

LIBER 15213 PG 013

OK - T. SMITH

93-1010

MAY - 1 1995

LAND CORNER RECORDATION CERTIFICATE

Filing Requirement of Act 74, Mich. P.A. 1970 9.00

MISCELLANEOUS RECORDING

For corners in

Oakland (County)

COMMISSION

Located In: Oakland Corner Code #

\$ 2.00 REMONUMENTATION
20 JAN 95 7:41 A.M. RECEIPT# 10B
PAID RECORDED - OAKLAND COUNTY
LYNN D. ALLEN, CLERK/REGISTER OF DEEDS


Table with 3 columns: Description, Township/Range/Section, and Corner Code. Includes rows for Public Land Survey, Property Controlling in Section, and Miscellaneous Property in Sec.

Compliance with ACT 345, P.A. 1990

APPROVED ON: 12-28-94
OAKLAND COUNTY REMONUMENTATION
PEER GROUP COMMITTEE
Register of Deeds Stamp & File Number

- 4. Lot No. , Recorded Plat
5. Private Claims

I, Grant J. Ward, RLS in a field survey on February 28, 1994, do hereby certify that under requirements of P.A. 74, Michigan P.A. of 1970, the corner points mentioned in lines 1 and 2 above were in conformance with regulations and rules therefore as required in the current manual of survey instructions of the United States Department of the Interior, Bureau of Land Management or by a decree of a Court of Law and/or that the corner points mentioned in lines 3, 4 and 5 above were in conformance with the rules of the Michigan Board of Land Surveyors or by a Decree of a Court of Law; established, re-established, monumented, re-monumented, recovered, found as expressed below:

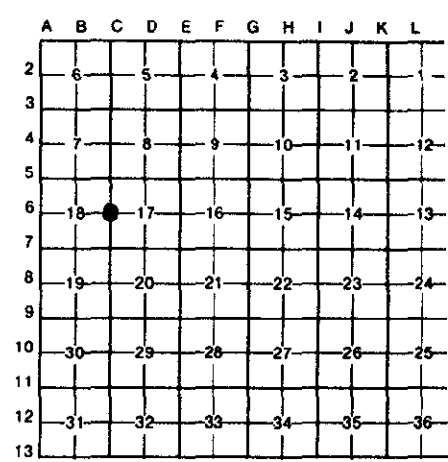

NOTE: Not more than 4 corners, all in the same town and range, may be recorded on this certificate.

A. Description of original monument and accessories and/or subsequent restoration:

C-6 Post, per G.L.O. Notes.

B. Description of corner evidence found and/or method applied in restoring or reestablishing corner:


C-6 Corner common to Sec. 17 and 18, T. 4 N., R. 11 E. Found 1/2" Iron Rod in the Centerline of Adams Road, even with road surface. Tree line to the East. This corner location is accepted as the best available evidence of the position of the corner.

Previously Recorded in L. 5862, P. 274 (2), L. 6965, P. 91 (1) and L. 9673, P. 254 (3) of Oakland County Records.

(n) Indicates the number of references that confirms this corner by dimensional tie.

C. Description of monument for corner and accessories established to perpetuate locating the position of the corner:

- C-6 Corner common to Sec. 17 and 18, T. 4 N., R. 11 E. Set 5/8" Iron Rod and Brass Cap #22445 in Monument Box in place of Found 1/2" Iron Rod.
S. 80° W. 59.21' Set P.K. Nail & Brass Disc #22445 in S. face of 12" Hickory.
N. 65° E. 44.10' Set P.K. Nail & Brass Disc #22445 in N. face of 3" Ash.
S. 50° E. 54.08' Set P.K. Nail & Brass Disc #22445 in NE. face of 4" Ash.
S. 33° W. 89.80' Set P.K. Nail & Brass Disc #22445 in NW. face of 24" Maple.
Due West 42.82' Found Iron Pipe.
N. 88° E. 59.95' Found Monument.

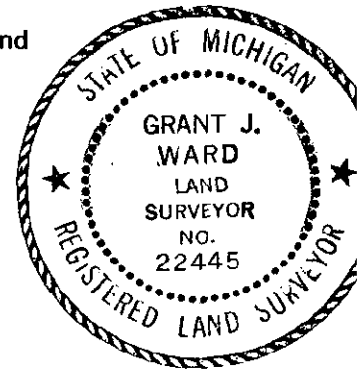

Signed by [Signature]
Surveyor's Michigan License No. 22445

Date December 27, 1994

93-1010