

SURVEY & REMONUMENTATION

LIBER **15213** PG **019**

JAN 20 1995 011214

OK - T. SMITH

93-1010 MAY - 1 1995
 For corners in **COMMISSION**
Oakland
(County)

LAND CORNER RECORDATION CERTIFICATE
 Filing Requirement of Act 74, Mich. P.A. 1970

\$ 9.00 MISCELLANEOUS RECORDING
 \$ 2.00 REMONUMENTATION
 20 JAN 95 7:41 A.M. RECEIPT# 108
 PAID RECORDED - OAKLAND COUNTY
 LYNN D. ALLEN, CLERK/REGISTER OF DEEDS

Located In: Oakland Corner Code #

1. Public Land Survey	T <u>4</u> N	R <u>11</u> E	<u>C-10</u>
	T	R	
	T	R	
	T	R	
2. Property Controlling in Section	S	T	R
	S	T	R
3. Miscellaneous Property in Sec.	S	T	R
	S	T	R

Compliance with ACT 345, P.A. 1990

APPROVED ON: 12-28-94
 OAKLAND COUNTY REMONUMENTATION PEER GROUP COMMITTEE
 Register of Deeds Stamp & File Number

4. Lot No. _____, Recorded Plat _____
 5. Private Claims _____

I, Grant J. Ward, RLS in a field survey on March 1, 19 94, do hereby certify that under requirements of P.A. 74, Michigan P.A. of 1970, the corner points mentioned in lines 1 and 2 above were in conformance with regulations and rules therefore as required in the current manual of survey instructions of the United States Department of the Interior, Bureau of Land Management or by a decree of a Court of Law and/or that the corner points mentioned in lines 3, 4 and 5 above were in conformance with the rules of the Michigan Board of Land Surveyors or by a Decree of a Court of Law; established, re-established, monumented, re-monumented, recovered, found as expressed below:

A	B	C	D	E	F	G	H	I	J	K	L
2	6	5	4	3	2	1					
3											
4	7	8	9	10	11	12					
5											
6	18	17	16	15	14	13					
7											
8	19	20	21	22	23	24					
9											
10	30	29	28	27	26	25					
11											
12	31	32	33	34	35	36					

NOTE: Not more than 4 corners, all in the same town and range, may be recorded on this certificate.

A. Description of original monument and accessories and/or subsequent restoration:

C-10 Post, per G.L.O. Notes.

File

B. Description of corner evidence found and/or method applied in restoring or reestablishing corner:

C-10 Corner common to Sec. 29 and 30, T. 4 N., R. 11 E. Found P.K. Nail and Disc (oblit.) 1' East of the Centerline of Adams Road. Tree lines run East and West. Fence runs East, West, and on R/Ws going South. This corner location is a careful and faithful perpetuation of the position of the original corner.


Previously Recorded in L. 11143, P. 695 (4); L. 11751, P. 003 (4); and L. 13590, P. 154 (4) of Oakland County Records.

(n) Indicates the number of references that confirms this corner by dimensional tie.

C. Description of monument for corner and accessories established to perpetuate locating the position of the corner:

C-10 Corner common to Sec. 29 and 30, T. 4 N., R. 11 E. Set Iron Rod and Brass Cap #22445 in Monument Box, in place of Found P.K. Nail and Disc (oblit.).

- N. 60° E. 31.61' Set P.K. Nail & Brass Disc #22445 in N. face of 20" Oak.
- S. 86° E. 28.07' Set P.K. Nail & Brass Disc #22445 in SW. face of twin 10" Elm.
- S. 63° W. 40.24' Set P.K. Nail & Brass Disc #22445 in NW. face of 12" Ash.
- S. 50° W. 33.10' Set P.K. Nail & Brass Disc #22445 in NW. face of 6" Oak.

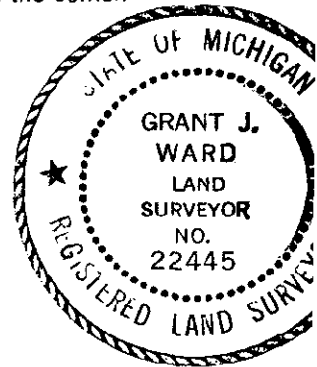

Signed by [Signature]
 Surveyor's Michigan License No. 22445

Date December 27, 1994

93-1010