

**SURVEY & REMONUMENTATION**

LIBER 15213 PG 021

JAN 20 95 011215

MAY - 1 1995

**LAND CORNER RECORDATION CERTIFICATE**

OK - T. SMITH

93-1010  
For corners in

**COMMISSION**

Filing Requirement of Act 74, Mich. P.A. 1970

9.00 MISCELLANEOUS RECORDING

\$ 2.00 REMONUMENTATION  
20 JAN 95 7:41 A.M. RECEIPT# 10B  
PAID RECORDED - OAKLAND COUNTY  
LYNN D. ALLEN, CLERK/REGISTER OF DEEDS

Compliance with  
ACT 345, P.A. 1990

APPROVED ON: 12-28-94  
OAKLAND COUNTY REMONUMENTATION  
PEER GROUP COMMITTEE

Register of Deeds Stamp & File Number

Oakland  
(County)

Located in: Oakland Corner Code #

1. Public Land Survey	T	<u>4N</u>	R	<u>11E</u>	<u>C-11</u>
	T		R		
	T		R		
	T		R		
2. Property Controlling in Section	S		T	R	
	S		T	R	
3. Miscellaneous Property in Sec.	S		T	R	
	S		T	R	

4. Lot No. \_\_\_\_\_, Recorded Plat \_\_\_\_\_  
5. Private Claims \_\_\_\_\_

I, Grant J. Ward, RLS, in a field survey on February 15, 19 94, do hereby certify that under requirements of P.A. 74, Michigan P.A. of 1970, the corner points mentioned in lines 1 and 2 above were in conformance with regulations and rules therefore as required in the current manual of survey instructions of the United States Department of the Interior, Bureau of Land Management or by a decree of a Court of Law and/or that the corner points mentioned in lines 3, 4 and 5 above were in conformance with the rules of the Michigan Board of Land Surveyors or by a Decree of a Court of Law, established, re-established, monumented, re-monumented, recovered, found as expressed below:

**NOTE: Not more than 4 corners, all in the same town and range, may be recorded on this certificate.**

A. Description of original monument and accessories and/or subsequent restoration:

C-11 Post, per G.L.O. Notes.

B. Description of corner evidence found and/or method applied in restoring or reestablishing corner:

C-11 Corner common to Sec. 29, 30, 31 and 32, T. 4 N., R. 11 E. Found Iron Bar in Monument Box in the Centerline of Silverbell Road and 7.5' West of the Centerline of Adams Road. Iron is 0.25' below Road surface. This corner location is accepted as a careful and faithful perpetuation of the position of the original corner.


Previously Recorded in L. 11143, P. 695 (3); and L. 13476, P. 674 (4) of Oakland County Records.

(n) Indicates the number of references that confirms this corner by dimensional tie.

C. Description of monument for corner and accessories established to perpetuate locating the position of the corner:

C-11 Corner common to Sec. 29, 30, 31 and 32, T. 4 N., R. 11 E. Set 5/8" Iron Rod and Brass Cap #22445 in Monument Box, in place of Found Iron Bar.


- N. 55° E. 64.42' Set P.K. Nail & Brass Disc #22445 in NW. face of Utility Pole.
- N. 42° W. 82.46' Set P.K. Nail & Brass Disc #22445 in SW. face of Utility Pole.
- S. 70° W. 77.26' Set P.K. Nail & Brass Disc #22445 in SE. face of Utility Pole.
- S. 47° E. 79.13' Set P.K. Nail & Brass Disc #22445 in NE. face 24" Catalpa.

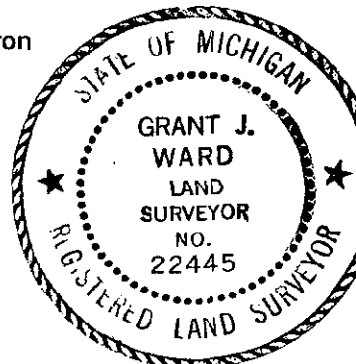

Signed by [Signature]  
Surveyor's Michigan License No. 22445

Date December 27, 1994

93-1010

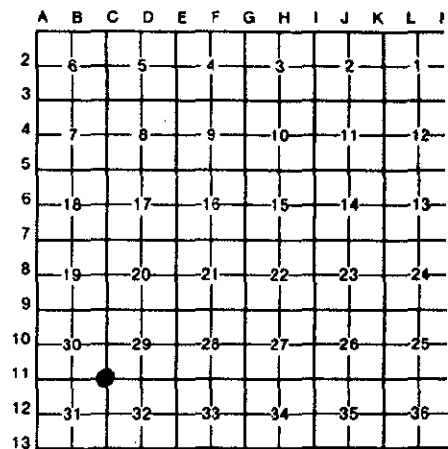

*[Handwritten signature]*