

MAY - 1 1995

LAND CORNER RECORDATION CERTIFICATE

OK - T. SMITH

93-1010 For corners in

COMMISSION

Filing Requirement of Act 74, Mich. P.A. 1970

\$ 9.00 MISCELLANEOUS RECORDING \$ 2.00 REMONUMENTATION

20 JAN 95 7:42 A.M. RECEIPT# 10B PAID RECORDED - OAKLAND COUNTY LYNN D. ALLEN, CLERK/REGISTER OF DEEDS

Oakland (County)

Located In: Oakland Corner Code #

- 1. Public Land Survey T 4N R 11E C-13
2. Property Controlling in Section S T R
3. Miscellaneous Property in Sec. S T R

Compliance with ACT 345, P.A. 1990

APPROVED ON: 12-28-94 OAKLAND COUNTY REMONUMENTATION PEER GROUP COMMITTEE

Register of Deeds Stamp & File Number

- 4. Lot No. , Recorded Plat
5. Private Claims

Grid table with columns A-L and rows 2-13. A dot is marked in cell C-12.

I, Grant J. Ward, RLS in a field survey on February 15, 1994 do hereby certify that under requirements of P.A. 74, Michigan P.A. of 1970, the corner points mentioned in lines 1 and 2 above were in conformance with regulations and rules therefore as required in the current manual of survey instructions of the United States Department of the Interior, Bureau of Land Management or by a decree of a Court of Law and/or that the corner points mentioned in lines 3, 4 and 5 above were in conformance with the rules of the Michigan Board of Land Surveyors or by a Decree of a Court of Law; established, re-established, monumented, re-monumented, recovered, found as expressed below:

NOTE: Not more than 4 corners, all in the same town and range, may be recorded on this certificate.

A. Description of original monument and accessories and/or subsequent restoration:

C-13 Post, per G.L.O. Notes.

Handwritten initials/signature.

B. Description of corner evidence found and/or method applied in restoring or reestablishing corner:

C-13 Corner common to Sec. 31, 32 and the Town Line, T. 4 N., R. 11 E. Found Iron Rod in Monument Box in the Centerline of Adams Road and 15' North of the Centerline of Dutton Road. Iron is 0.15' below Road surface. This corner location is a careful and faithful perpetuation of the position of the original corner.


Previously Recorded in L. 11476, P. 480 (3); and L. 12134, P. 344 (3) of Oakland County Records. Previously Recorded in L. 6025, P. 559 (C-1 in Avon Twp.) (1); and L. 6247, P. 723 (C-1 in Avon Twp.) (1) of Oakland County Records.

(n) Indicates the number of references that confirms this corner by dimensional tie.

C. Description of monument for corner and accessories established to perpetuate locating the position of the corner:

C-13 Corner common to Sec. 31, 32 and the Town Line, T. 4 N., R. 11 E. Set 5/8" Iron Rod and Brass Cap #22445 adjoining Found Iron Rod, in Monument Box.

- N. 30° E. 157.25' Set P.K. Nail & Brass Disc #22445 in NW. face of Utility Pole.
N. 67° W. 61.60' Set P.K. Nail & Brass Disc #22445 in S. face of 30" Oak.
S. 55° W. 77.59' Set P.K. Nail & Brass Disc #22445 in NW. face of Light Pole.
S. 36° E. 64.48' Chiseled "+" in N. rim of Storm Manhole.
S. 47° E. 84.78' Found Iron Rod.

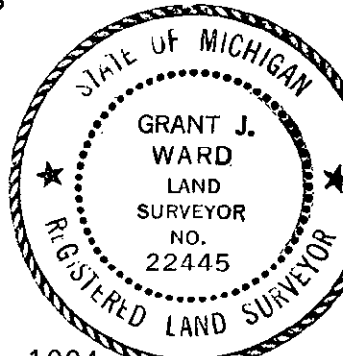

Signed by [Signature]

Date December 27, 1994

Surveyor's Michigan License No. 22445