

SURVEY & REMONUMENTATION

LIBER 15213 PG 031

JAN 20 95 011220

OK - T. SMITH

93-1010

MAY - 1 1995

LAND CORNER RECORDATION CERTIFICATE

Filing Requirement of Act 74, Mich. P.A. 1970

9.00 MISCELLANEOUS RECORDING

For corners in Oakland (County)

COMMISSION

Located In: Oakland Corner Code #

\$ 2.00 REMONUMENTATION  
20 JAN 95 7:42 A.M. RECEIPT# 108  
PAID RECORDED - OAKLAND COUNTY  
LYNN D. ALLEN, CLERK/REGISTER OF DEEDS

- 1. Public Land Survey T 4N R 11E D-9
2. Property Controlling in Section S T R
3. Miscellaneous Property in Sec. S T R

Compliance with ACT 345, P.A. 1990

APPROVED ON: 12-07-94 OAKLAND COUNTY REMONUMENTATION PEER GROUP COMMITTEE Register of Deeds Stamp & File Number


- 4. Lot No. Recorded Plat
5. Private Claims

I, Grant J. Ward, RLS in a field survey on February 23, 1994 do hereby certify that under requirements of P.A. 74, Michigan P.A. of 1970, the corner points mentioned in lines 1 and 2 above were in conformance with regulations and rules therefore as required in the current manual of survey instructions of the United States Department of the Interior, Bureau of Land Management or by a decree of a Court of Law and/or that the corner points mentioned in lines 3, 4 and 5 above were in conformance with the rules of the Michigan Board of Land Surveyors or by a Decree of a Court of Law; established, re-established, monumented, re-monumented, recovered, found as expressed below:

NOTE: Not more than 4 corners, all in the same town and range, may be recorded on this certificate.

A. Description of original monument and accessories and/or subsequent restoration:

D-9 Post, per G.L.O. Notes.

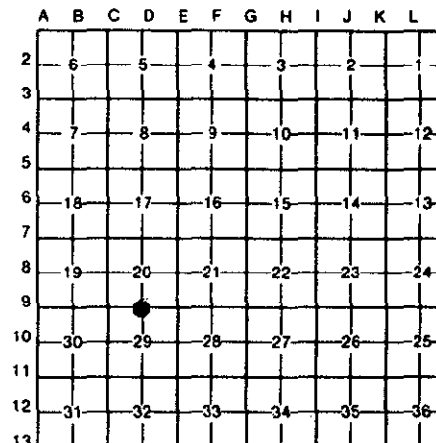

B. Description of corner evidence found and/or method applied in restoring or reestablishing corner:

D-9 Corner common to Sec. 20 and 29 T. 4 N., R. 11 E. Found 1/2" Iron Rod, 0.35' below Road surface, 3' North of the Centerline of Gunn Road. Tree row to the South. This corner location is a careful and faithful perpetuation of the position of the original corner.

Previously Recorded in L. 6384, P. 805 (3); and L.7758, P. 674 (3) of Oakland County Records.

(n) Indicates the number of references that confirms this corner by dimensional tie.

C. Description of monument for corner and accessories established to perpetuate locating the position of the corner:

- D-9 Corner common to Sec. 20 and 29, T. 4 N., R. 11 E. Set 3/4" Iron Rod and Brass Cap #22445 adjoining Found 1/2" Iron Rod.
Due North 32.93' Found Monument.
N. 54° E. 46.31' Set P.K. Nail & Brass Disc #22445 in NW. face of 14" Oak.
S. 69° E. 55.82' Set P.K. Nail & Brass Disc #22445 in S. face of 14" Cherry.
S. 18° W. 27.86' Set P.K. Nail & Brass Disc #22445 in NW. face of 22" Oak.
Due West 49.81' Found 1/2" Iron Rod.
S. 01° E. 32.93' Found Iron Rod & Cap #28408.
S. 88° W. 49.81' Found Iron Rod.



Signed by [Signature] Surveyor's Michigan License No. 22445

Date November 28, 1994