

SURVEY & REMONUMENTATION

LIBER 15213 PC 033

JAN 20 95 01 12 21

MAY - 1 1995

LAND CORNER RECORDATION CERTIFICATE

OK - T. SMITH

93-1010 For corners in

COMMISSION

Filing Requirement of Act 74, Mich. P.A. 1970, 9.00

MISCELLANEOUS RECORDING

\$ 2.00 REMONUMENTATION

20 JAN 95 7:42 A.M. RECEIPT# 198 PAID RECORDED - OAKLAND COUNTY LYNN D. ALLEN, CLERK/REGISTER OF DEEDS

Oakland (County)

Located In: Oakland Corner Code #

- 1. Public Land Survey T 4N R 11E D-11
2. Property Controlling in Section S T R
3. Miscellaneous Property in Sec. S T R

Compliance with ACT 345, P.A. 1990

APPROVED ON: 12-07-94 OAKLAND COUNTY REMONUMENTATION PEER GROUP COMMITTEE Register of Deeds Stamp & File Number

- 4. Lot No. Recorded Plat
5. Private Claims

I, Grant J. Ward, RLS in a field survey on February 14, 1994 do hereby certify that under requirements of P.A. 74, Michigan P.A. of 1970, the corner points mentioned in lines 1 and 2 above were in conformance with regulations and rules therefore as required in the current manual of survey instructions of the United States Department of the Interior, Bureau of Land Management or by a decree of a Court of Law and/or that the corner points mentioned in lines 3, 4 and 5 above were in conformance with the rules of the Michigan Board of Land Surveyors or by a Decree of a Court of Law; established, re-established, monumented, re-monumented, recovered, found as expressed below:

NOTE: Not more than 4 corners, all in the same town and range, may be recorded on this certificate.

Grid table with columns A-L and rows 1-13. A dot is marked at the intersection of column C and row 12.

A. Description of original monument and accessories and/or subsequent restoration:

D-11 Post, per G.L.O. Notes.

B. Description of corner evidence found and/or method applied in restoring or reestablishing corner:

D-11 Corner common to Sec. 29 and 32, T. 4 N., R. 11 E. Found 1/2" Iron Rod, 3.5' North and 7.5' West of the Centerline/Centerline of Brewster and Silverbell Roads. Iron is 0.2' below Road surface. This corner location is a careful and faithful perpetuation of the position of the original corner.


Previously Recorded in L. 6455, P. 192 (3); L. 11143, P. 695 (4); and L. 13476, P. 674 (4) of Oakland County Records.

(n) Indicates the number of references that confirms this corner by dimensional tie.

C. Description of monument for corner and accessories established to perpetuate locating the position of the corner:

D-11 Corner common to Sec. 29 and 32, T. 4 N., R. 11 E. Set 5/8" Iron Rod and Brass Cap #22445 adjoining Found 1/2 Iron Rod.

- N. 67° W. 61.56' Set P.K. Nail & Brass Disc #22445 in S. face of 18" Oak.
N. 21° E. 29.90' Set P.K. Nail & Brass Disc #22445 in W. face of 14" Maple.
N. 75° E. 68.67' Set P.K. Nail & Brass Disc #22445 in NW. face of 10" Cherry.
S. 20° W. 57.37' Set P.K. Nail & Brass Disc #22445 in SE. face of 24" Oak.
S. 81° W. 44.58' Found Iron Pipe in Centerline of Silverbell Road.

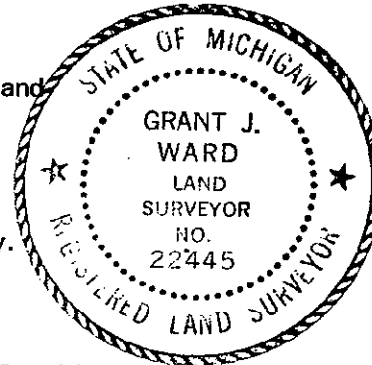

Signed by [Signature]

Date November 28, 1994

Surveyor's Michigan License No. 22445

93-1010