

SURVEY & RE-MONUMENTATION

LIBER 15213 PG 045

JAN 20 95 011227

93-1010

MAY - 1 1995

LAND CORNER RECORDATION CERTIFICATE

OK - T. SMITH

For corners in

Filing Requirement of Act 74, Mich. P.A. 1970

\$ 9.00 MISCELLANEOUS RECORDING

COMMISSION

Oakland (County)

Located In: Oakland Corner Code #

\$ 2.00 REMONUMENTATION

20 JAN 95 7:43 A.M. RECEIPT# 108 PAID RECORDED - OAKLAND COUNTY LYNN D. ALLEN, CLERK/REGISTER OF DEEDS

Compliance with ACT 345, P.A. 1990

APPROVED ON: 2-9-94 OAKLAND COUNTY REMONUMENTATION PEER GROUP COMMITTEE

Register of Deeds Stamp & File Number

- 1. Public Land Survey T 4N R 11E E-5
2. Property Controlling in Section S T R
3. Miscellaneous Property in Sec. S T R

- 4. Lot No. Recorded Plat
5. Private Claims

I, Grant J. Ward, RLS, in a field survey on December 17, 1993, do hereby certify that under requirements of P.A. 74, Michigan P.A. of 1970, the corner points mentioned in lines 1 and 2 above were in conformance with regulations and rules therefore as required in the current manual of survey instructions of the United States Department of the Interior, Bureau of Land Management or by a decree of a Court of Law and/or that the corner points mentioned in lines 3, 4 and 5 above were in conformance with the rules of the Michigan Board of Land Surveyors or by a Decree of a Court of Law; established, re-established, monumented, re-monumented, recovered, found as expressed below:

NOTE: Not more than 4 corners, all in the same town and range, may be recorded on this certificate.

A. Description of original monument and accessories and/or subsequent restoration:

E-5 Post, per G.L.O. Notes.

B. Description of corner evidence found and/or method applied in restoring or reestablishing corner:

E-5 Corner common to Sec. 8, 9, 16 and 17, T. 4 N., R. 11 E. Found 1" Iron Bar in Monument Box. 0.5' below asphalt, 1' West of the Centerline of Lake George Road and in the Centerline of Stoney Creek Road. This corner location is a careful and faithful perpetuation of the position of the original corner.


Previously Recorded in L. 5805, P. 260 (0); L. 9063, P. 278 (2); and L. 10434, P. 808 (3) of Oakland County Records.

(n) Indicates the number of references that confirms this corner by dimensional tie.

C. Description of monument for corner and accessories established to perpetuate locating the position of the corner:

E-5 Corner common to Sec. 8, 9, 16 and 17, T. 4 N., R. 11 E. Set 5/8" Rod and Brass Cap #22445 in Monument Box.


- S. 6° W. 141.21' Set P.K. Nail & Brass Disc #22445 in E. face of 5" Poplar Cluster.
S. 41° E. 175.27' Set P.K. Nail & Brass Disc #22445 in SW. face of Utility Pole.
N. 54° E. 139.13' Set P.K. Nail & Brass Disc #22445 in SE. face of Utility Pole.
N. 87° W. 290.24' Set P.K. Nail & Brass Disc #22445 in S. face of 22" Oak.
N. 45° E. 45.31' Found Iron Rod.

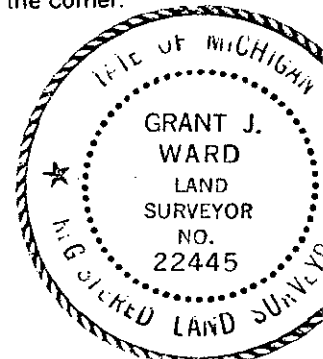

Signed by [Signature] Surveyor's Michigan License No. 22445

Date December 15, 1994

93-1010

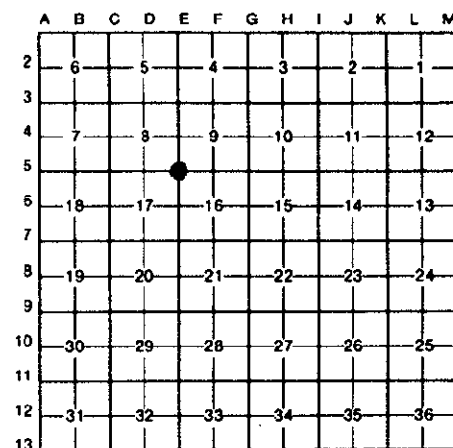

Handwritten signature/initials.