

**SURVEY &  
REMONUMENTATION**

JAN 20 95 011228

LIBER 15213 PG 047

MAY - 1 1995

**LAND CORNER RECORDATION CERTIFICATE**  
Filing Requirement of Act 74, Mich. P.A. 1970

93-1010  
For corners in

**COMMISSION**

OK - T. SMITH

Oakland  
(County)

Located In: Oakland Corner Code #

1. Public Land Survey	T	<u>4N</u>	R	<u>11E</u>	<u>E-6</u>
	T		R		
	T		R		
	T		R		
	T		R		
2. Property Controlling in Section	S		T		
	S		T		
3. Miscellaneous Property in Sec.	S		T		
	S		T		

\$ 9.00 MISCELLANEOUS RECORDING  
\$ 2.00 REMONUMENTATION  
20 JAN 95 7:43 A.M. RECEIPT# 10B  
PAID RECORDED - OAKLAND COUNTY  
LYNN D. ALLEN, CLERK/REGISTER OF DEEDS  
ACT 345, P.A. 1990

APPROVED ON: 2-9-94  
OAKLAND COUNTY REMONUMENTATION  
PEER GROUP COMMITTEE  
Register of Deeds Stamp & File Number

4. Lot No. \_\_\_\_\_, Recorded Plat \_\_\_\_\_  
5. Private Claims \_\_\_\_\_

I, Grant J. Ward, RLS, in a field survey on December 30, 19 93, do hereby certify that under requirements of P.A. 74, Michigan P.A. of 1970, the corner points mentioned in lines 1 and 2 above were in conformance with regulations and rules therefore as required in the current manual of survey instructions of the United States Department of the Interior, Bureau of Land Management or by a decree of a Court of Law and/or that the corner points mentioned in lines 3, 4 and 5 above were in conformance with the rules of the Michigan Board of Land Surveyors or by a Decree of a Court of Law; established, re-established, monumented, re-monumented, recovered, found as expressed below:

**NOTE: Not more than 4 corners, all in the same town and range, may be recorded on this certificate.**

A. Description of original monument and accessories and/or subsequent restoration:

E-6 Post, per G.L.O. Notes.

	A	B	C	D	E	F	G	H	I	J	K	L	M
2	6		5		4		3		2		1		
3													
4	7		8		9		10		11		12		
5													
6	18		17		16		15		14		13		
7													
8	19		20		21		22		23		24		
9													
10	30		29		28		27		26		25		
11													
12	31		32		33		34		35		36		
13													

B. Description of corner evidence found and/or method applied in restoring or reestablishing corner:

E-6 Corner common to Sec. 16 and 17, T. 4 N., R. 11 E. Found "T" Iron, 1' West of the Centerline of Lake George Road, 0.2' below Road surface. Tree line to the East and fence to the East. This corner location is a careful and faithful perpetuation of the position of the original corner.


Previously Recorded in L. 6310, P. 136 (3) of Oakland County Records.

(n) Indicates the number of references that confirms this corner by dimensional tie.

C. Description of monument for corner and accessories established to perpetuate locating the position of the corner:

E-6 Corner common to Sec. 16 and 17, T. 4 N., R. 11 E. Set 5/8 Iron Rod and Brass Cap #22445 adjoining Found "T" Iron.

- S. 75° E. 26.85' Set P.K. Nail & Brass Disc #22445 in S. face of 18" Oak.
- S. 06° E. 75.38' Set P.K. Nail & Brass Disc #22445 in W. face of 12" Cherry.
- S. 41° W. 32.41' Set P.K. Nail & Brass Disc #22445 in SE. face of 4" Pine.
- N. 15° W. 56.27' Set P.K. Nail & Brass Disc #22445 in E. face of 20" & 16" Oak.
- S. 02° E. 2.68' Found Iron Rod.

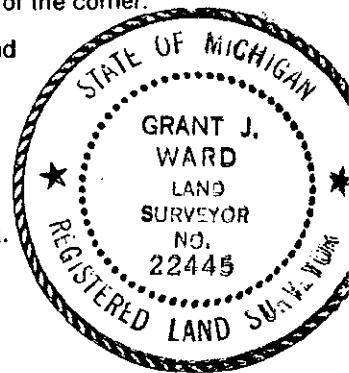

Signed by [Signature]  
Surveyor's Michigan License No. 22445

Date December 15, 1994

93-1010