

**SURVEY &
REMONUMENTATION**

LIBER **15213** PG **051**

JAN 20 95 011230

MAY - 1 1995

OK - T. SMITH

93-1010
For corners in
Oakland

COMMISSION

LAND CORNER RECORDATION CERTIFICATE
Filing Requirement of Act 74, Mich. P.A. 1970

9.00 MISCELLANEOUS RECORDING
2.00 REMONUMENTATION
20 JAN 95 7:44 A.M. RECEIPT# 10B
PAID RECORDED - OAKLAND COUNTY
LYNN D. ALLEN, CLERK/REGISTER OF DEEDS

Located In: Oakland Corner Code #

1. Public Land Survey	T	<u>4N</u>	R	<u>11E</u>	<u>E-8</u>
	T	_____	R	_____	_____
	T	_____	R	_____	_____
	T	_____	R	_____	_____
2. Property Controlling in Section	S	_____	T	_____	_____
	S	_____	T	_____	_____
3. Miscellaneous Property in Sec.	S	_____	T	_____	_____
	S	_____	T	_____	_____

Compliance with
ACT 345, P.A. 1990

APPROVED ON: 2-9-94
OAKLAND COUNTY REMONUMENTATION
PEER GROUP COMMITTEE
Register of Deeds Stamp & File Number

4. Lot No. _____, Recorded Plat _____
5. Private Claims _____

	A	B	C	D	E	F	G	H	I	J	K	L	M
2	6		5		4		3		2		1		
3													
4	7		8		9		10		11		12		
5													
6	13		17		16		15		14		13		
7													
8	19		20		21		22		23		24		
9													
10	30		29		28		27		26		25		
11													
12	31		32		33		34		35		36		
13													

I, Grant J. Ward, RLS in a field survey on December 16, 19 93, do hereby certify that under requirements of P.A. 74, Michigan P.A. of 1970, the corner points mentioned in lines 1 and 2 above were in conformance with regulations and rules therefore as required in the current manual of survey instructions of the United States Department of the Interior, Bureau of Land Management or by a decree of a Court of Law and/or that the corner points mentioned in lines 3, 4 and 5 above were in conformance with the rules of the Michigan Board of Land Surveyors or by a Decree of a Court of Law; established, re-established, monumented, re-monumented, recovered, found as expressed below:

NOTE: Not more than 4 corners, all in the same town and range, may be recorded on this certificate.

A. Description of original monument and accessories and/or subsequent restoration:

E-8 Post, per G.L.O. Notes.

B. Description of corner evidence found and/or method applied in restoring or reestablishing corner:

E-8 Corner common to Sec. 20 and 21, T. 4 N., R. 11 E. Found 1" Iron Pipe, 3' East of the Centerline of Lake George Road and 7' North of the Centerline of the gravel drive of house no. 3590, 0.15' below Road surface. Fence line to the East and tree row to the West. This corner location is a careful and faithful perpetuation of the position of the original corner.


Previously Recorded in L. 5921, P. 407 (3); L. 8599, P. 133 (3); and L. 11861, P. 023 (4) of Oakland County Records.

(n) Indicates the number of references that confirms this corner by dimensional tie.

C. Description of monument for corner and accessories established to perpetuate locating the position of the corner:

E-8 Corner common to Sec. 20 and 21, T. 4 N., R. 11 E. Set 5/8" Iron Rod and Brass Cap #22445 adjoining Found 1" Iron Pipe.

- Due East 33.05' Found Monument.
- S. 43° E. 39.50' Set P.K. Nail & Brass Disc #22445 in SW. face of 16" Oak.
- S. 65° W. 31.65' Set P.K. Nail & Brass Disc #22445 in SE. face of 18" Oak.
- N. 55° W. 24.63' Set P.K. Nail & Brass Disc #22445 in S. face of 28" Maple.

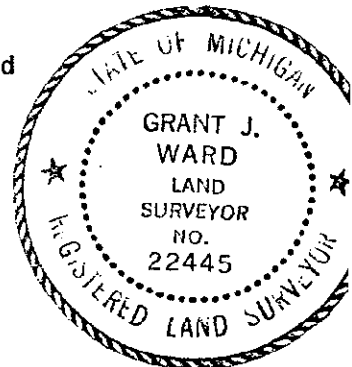

Signed by [Signature]
Surveyor's Michigan License No. 22445

Date December 15, 1994

93-1010