

**SURVEY &
REMONUMENTATION**

JAN 20 95 011231

LIBER 15213 PC 053

MAY - 1 1995

LAND CORNER RECORDATION CERTIFICATE
Filing Requirement of Act 74, Mich. P.A. 1970

OK - T. SMITH

93-1010
For corners in

COMMISSION

\$ 9.00 MISCELLANEOUS RECORDING
\$ 2.00 REMONUMENTATION
20 JAN 95 7:44 A.M. RECEIPT# 108
PAID RECORDED - OAKLAND COUNTY
LYNN D. ALLEN, CLERK/REGISTER OF DEEDS

Oakland Located In: Oakland Corner Code #
(County)

1. Public Land Survey	T	<u>4N</u>	R	<u>11E</u>	<u>E-9</u>
	T		R		
	T		R		
	T		R		
2. Property Controlling in Section	S		T		R
	S		T		R
3. Miscellaneous Property in Sec.	S		T		R
	S		T		R

Compliance with
ACT 345, P.A. 1990

APPROVED ON: 2-9-94
OAKLAND COUNTY REMONUMENTATION
PEER GROUP COMMITTEE
Register of Deeds Stamp & File Number

4. Lot No. _____, Recorded Plat _____
5. Private Claims _____

I, Grant J. Ward, RLS, in a field survey on December 16, 19 93, do hereby certify that under requirements of P.A. 74, Michigan P.A. of 1970, the corner points mentioned in lines 1 and 2 above were in conformance with regulations and rules therefore as required in the current manual of survey instructions of the United States Department of the Interior, Bureau of Land Management or by a decree of a Court of Law and/or that the corner points mentioned in lines 3, 4 and 5 above were in conformance with the rules of the Michigan Board of Land Surveyors or by a Decree of a Court of Law; established, re-established, monumented, re-monumented, recovered, found as expressed below:

A	B	C	D	E	F	G	H	I	J	K	L	M
2	6	5	4	3	2	1						
3												
4	7	8	9	10	11	12						
5												
6	18	17	16	15	14	13						
7												
8	19	20	21	22	23	24						
9												
10	30	29	28	27	26	25						
11												
12	31	32	33	34	35	36						
13												

NOTE: Not more than 4 corners, all in the same town and range, may be recorded on this certificate.

A. Description of original monument and accessories and/or subsequent restoration:

E-9 Post, per G.L.O. Notes.

B. Description of corner evidence found and/or method applied in restoring or reestablishing corner:

E-9 Corner common to Sec. 20, 21, 28 and 29, T. 4 N., R. 11 E. Found 1/2" Iron Rod, very rusty on top, 0.35' below Road surface, 0.6' North of the Centerline of Gunn Road and 10' East of gravel drive. Fence and tree line to the South. This corner location is a careful and faithful perpetuation of the position of the original corner.


Previously Recorded in L. 6877, P. 563 (2); L. 7758, P. 674 (3); and L. 8713, P. 455 (3) of Oakland County Records.

(n) Indicates the number of references that confirms this corner by dimensional tie.

C. Description of monument for corner and accessories established to perpetuate locating the position of the corner:

E-9 Corner common to Sec. 20, 21, 28 and 29, T. 4 N., R. 11 E. Set 5/8" Iron Rod and Brass Cap #22445 adjoining Found 1/2" Iron Rod.

- N. 04° W. 26.27' Set P.K. Nail & Brass Disc #22445 in W. face of 18" Basswood.
- N. 41° W. 47.22' Set P.K. Nail & Brass Disc #22445 in NE. face of Utility Pole.
- S. 64° E. 46.25' Set P.K. Nail & Brass Disc #22445 in N. face of 20" & 16" Elm.
- S. 29° E. 31.68' Set P.K. Nail & Brass Disc #22445 in NE. face of 18" Ash.

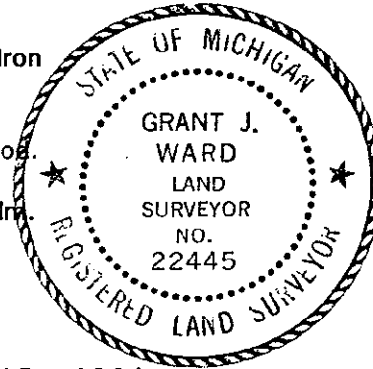

Signed by [Signature]
Surveyor's Michigan License No. 22445

Date December 15, 1994

93-1010