

**SURVEY & REMONUMENTATION**

LIBER **15213** PC **055**

JAN 20 1995 011232

OK - T. SMITH

MAY - 1 1995

**LAND CORNER RECORDATION CERTIFICATE**

Filing Requirement of Act 74, Mich. P.A. 1970

\$ 9.00 MISCELLANEOUS RECORDING

\$ 2.00 REMONUMENTATION

20 JAN 95 7:44 A.M. RECEIPT# 10B  
PAID RECORDED - OAKLAND COUNTY  
LYNN D. ALLEN, CLERK/REGISTER OF DEEDS

93-1010

For corners in

**COMMISSION**

Oakland  
(County)

Located In: Oakland Corner Code #

1. Public Land Survey	T <u>4</u> N	R <u>11</u> E	<u>E-10</u>
	T _____	R _____	_____
	T _____	R _____	_____
	T _____	R _____	_____
2. Property Controlling in Section	S _____	T _____	R _____
	S _____	T _____	R _____
3. Miscellaneous Property in Sec.	S _____	T _____	R _____
	S _____	T _____	R _____

Compliance with ACT 345, P.A. 1990

APPROVED ON: 12-07-94  
OAKLAND COUNTY REMONUMENTATION PEER GROUP COMMITTEE  
Register of Deeds Stamp & File Number

4. Lot No. \_\_\_\_\_, Recorded Plat \_\_\_\_\_  
5. Private Claims \_\_\_\_\_

I, Grant J. Ward, RLS in a field survey on February 23, 19 94, do hereby certify that under requirements of P.A. 74, Michigan P.A. of 1970, the corner points mentioned in lines 1 and 2 above were in conformance with regulations and rules therefore as required in the current manual of survey instructions of the United States Department of the Interior, Bureau of Land Management or by a decree of a Court of Law and/or that the corner points mentioned in lines 3, 4 and 5 above were in conformance with the rules of the Michigan Board of Land Surveyors or by a Decree of a Court of Law; established, re-established, monumented, re-monumented, recovered, found as expressed below:

A	B	C	D	E	F	G	H	I	J	K	L	M
2	6	5	4	3	2	1						
3												
4	7	8	9	10	11	12						
5												
6	18	17	16	15	14	13						
7												
8	19	20	21	22	23	24						
9												
10	30	29	28	27	26	25						
11												
12	31	32	33	34	35	36						
13												

**NOTE: Not more than 4 corners, all in the same town and range, may be recorded on this certificate.**

A. Description of original monument and accessories and/or subsequent restoration:

E-10 Post, per G.L.O. Notes.

B. Description of corner evidence found and/or method applied in restoring or reestablishing corner:

E-10 Corner common to Sec. 28 and 29, T. 4 N., R. 11 E. Found 3/4" Iron Pipe, 0.2' above surface. This corner location is a careful and faithful perpetuation of the position of the original corner.


Previously Recorded in L. 14104, P. 678 (4) of Oakland County Records.

(n) Indicates the number of references that confirms this corner by dimensional tie.

C. Description of monument for corner and accessories established to perpetuate locating the position of the corner:

E-10 Corner common to Sec. 28 and 29, T. 4 N., R. 11 E. Set Concrete Monument and Brass Cap #22445 in place of Found 3/4" Iron Pipe.

- N. 88° E. 1.21' Set P.K. Nail & Brass Disc #22445 in SE. face of 30" Oak.
- N. 88° W. 136.16' Set P.K. Nail & Brass Disc #22445 in NW. face of 36" Oak.
- S. 36° W. 87.17' Set P.K. Nail & Brass Disc #22445 in W. face of 24" Oak.
- Due South 104.94' Set P.K. Nail & Brass Disc #22445 in NE. face of 30" Oak.

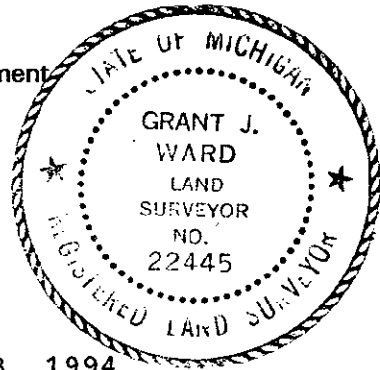

Signed by [Signature]

Date November 28, 1994

Surveyor's Michigan License No. 22445