

**SURVEY & REMONUMENTATION**

LIC# 15213 PG 057

JAN 20 95 011233

93-1010

MAY - 1 1995

**LAND CORNER RECORDATION CERTIFICATE**

Filing Requirement of Act 74, Mich. P.A. 1970

OK - T. SMITH  
9.00 MISCELLANEOUS RECORDING  
2.00 REMONUMENTATION

For corners in  
Oakland  
(County)

COMMISSION

Located In: Oakland Corner Code #

20 JAN 95 7:44 A.M. RECEIPT# 10B  
PAID RECORDED - OAKLAND COUNTY  
LYNN D. ALLEN, CLERK/REGISTER OF DEEDS

1. Public Land Survey	T	<u>4N</u>	R	<u>11E</u>	<u>E-11</u>
	T	_____	R	_____	_____
	T	_____	R	_____	_____
	T	_____	R	_____	_____
2. Property Controlling in Section	S	_____	T	_____	_____
	S	_____	T	_____	_____
3. Miscellaneous Property in Sec.	S	_____	T	_____	_____
	S	_____	T	_____	_____

Compliance with  
ACT 345, P.A. 1990

APPROVED ON: 12-07-94  
OAKLAND COUNTY REMONUMENTATION  
PEER GROUP COMMITTEE  
Register of Deeds Stamp & File Number

4. Lot No. \_\_\_\_\_, Recorded Plat \_\_\_\_\_  
5. Private Claims \_\_\_\_\_

	A	B	C	D	E	F	G	H	I	J	K	L	M
2	6		5		4		3		2		1		
3													
4	7		8		9		10		11		12		
5													
6	18		17		16		15		14		13		
7													
8	19		20		21		22		23		24		
9													
10	30		29		28		27		26		25		
11													
12	31		32		33		34		35		36		
13													

I, Grant J. Ward, RLS in a field survey on February 15, 19 94, do hereby certify that under requirements of P.A. 74, Michigan P.A. of 1970, the corner points mentioned in lines 1 and 2 above were in conformance with regulations and rules therefore as required in the current manual of survey instructions of the United States Department of the Interior, Bureau of Land Management or by a decree of a Court of Law and/or that the corner points mentioned in lines 3, 4 and 5 above were in conformance with the rules of the Michigan Board of Land Surveyors or by a Decree of a Court of Law; established, re-established, monumented, re-monumented, recovered, found as expressed below:

**NOTE: Not more than 4 corners, all in the same town and range, may be recorded on this certificate.**

A. Description of original monument and accessories and/or subsequent restoration:

E-11 Post, per G.L.O. Notes.

B. Description of corner evidence found and/or method applied in restoring or reestablishing corner:

E-11 Corner common to Sec. 28, 29, 32 and 33, T. 4 N., R. 11 E. Found 1/2" Iron Pipe, 1' South of the Centerline of Silverbell Road. Lines up with the Centerline of Subdivision Road to South. Iron is 1' below Road surface. This corner location is a careful and faithful perpetuation of the position of the original corner.


Previously Recorded in L. 6455, P. 192 (2); L. 7980, P. 385 (0); L. 10281, P. 622 (0); and L. 13476, P. 673 (4) of Oakland County Records.

(n) Indicates the number of references that confirms this corner by dimensional tie.

C. Description of monument for corner and accessories established to perpetuate locating the position of the corner:

E-11 Corner common to Sec. 28, 29, 32 and 33, T. 4 N., R. 11 E. Set 5/8" Iron Rod and Brass Cap #22445 adjoining Found 1/2" Iron Pipe.

- N. 47° W. 32.74' Set P.K. Nail & Brass Disc #22445 in SW. face of 16" Walnut.
- N. 10° E. 58.92' Set P.K. Nail & Brass Disc #22445 in W. face of Utility Pole.
- S. 60° E. 59.37' Set P.K. Nail & Brass Disc #22445 in NE. face of 14" Ash.
- Due South 85.15' Set P.K. Nail & Brass Disc #22445 in E. face of 4" Elm.
- S. 59° E. 59.34' Found Iron Rod.

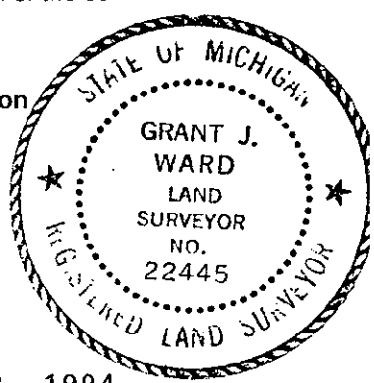

Signed by [Signature] Date November 28, 1994  
Surveyor's Michigan License No. 22445