

SURVEY & REMONUMENTATION

LIC# 15213pc059

JAN 20 95 011234

MAY - 1 1995

LAND CORNER RECORDATION CERTIFICATE

OK - T. SMITH

Filing Requirement of Act 74, Mich. P.A. 1970# 9.00

93-1010
For corners in

COMMISSION

MISCELLANEOUS RECORDING

\$ 2.00 REMONUMENTATION

20 JAN 95 7:46 A.M. RECEIPT# 11B
PAID RECORDED - OAKLAND COUNTY
LYNN D. ALLEN, CLERK/REGISTER OF DEEDS

Oakland (County) Located In: Oakland Corner Code ##

- | | | | | | |
|------------------------------------|---|-----------|---|------------|-------------|
| 1. Public Land Survey | T | <u>4N</u> | R | <u>11E</u> | <u>E-12</u> |
| | T | | R | | |
| | T | | R | | |
| | T | | R | | |
| 2. Property Controlling in Section | S | | T | R | |
| | S | | T | R | |
| 3. Miscellaneous Property in Sec. | S | | T | R | |
| | S | | T | R | |

Compliance with ACT 345, P.A. 1990

APPROVED ON: 12-07-94
OAKLAND COUNTY REMONUMENTATION PEER GROUP COMMITTEE
Register of Deeds Stamp & File Number

4. Lot No. _____, Recorded Plat _____
5. Private Claims _____

I, Grant J. Ward, RLS in a field survey on February 17, 19 94, do hereby certify that under requirements of P.A. 74, Michigan P.A. of 1970, the corner points mentioned in lines 1 and 2 above were in conformance with regulations and rules therefore as required in the current manual of survey instructions of the United States Department of the Interior, Bureau of Land Management or by a decree of a Court of Law and/or that the corner points mentioned in lines 3, 4 and 5 above were in conformance with the rules of the Michigan Board of Land Surveyors or by a Decree of a Court of Law; established, re-established, monumented, re-monumented, recovered, found as expressed below:

NOTE: Not more than 4 corners, all in the same town and range, may be recorded on this certificate.

	A	B	C	D	E	F	G	H	I	J	K	L	M
2			5		4		3		2		1		
3													
4		7		8		9		10		11		12	
5													
6	18		17		16		15		14		13		
7													
8	19		20		21		22		23		24		
9													
10	30		29		28		27		26		25		
11													
12	31		32		33		34		35		36		
13													

A. Description of original monument and accessories and/or subsequent restoration:

E-12 Post, per G.L.O. Notes.

B. Description of corner evidence found and/or method applied in restoring or reestablishing corner:


E-12 Corner common to Sec. 32 and 33, T. 4 N., R. 11 E. Found 1/2" Iron Rod, 0.3' above ground surface. "Old" Fence lines to the East and South. This corner location is a careful and faithful perpetuation of the position of the original corner.

Previously Unrecorded in Oakland County Records.

C. Description of monument for corner and accessories established to perpetuate locating the position of the corner:

E-12 Corner common to Sec. 32 and 33, T. 4 N., R. 11 E. Set 5/8" Iron Rod and Brass Cap #22445 adjoining Found 1/2" Iron Rod.

- N. 05° E. 29.00' Set P.K. Nail & Brass Disc #22445 in W. face of 14" Maple.
- S. 87° E. 42.97' Set P.K. Nail & Brass Disc #22445 in N. face of 16" Maple.
- S. 13° E. 16.32' Set P.K. Nail & Brass Disc #22445 in NE. face of 18" Oak.
- N. 45° W. 35.09' Set P.K. Nail & Brass Disc #22445 in SW. face of 12" Oak.

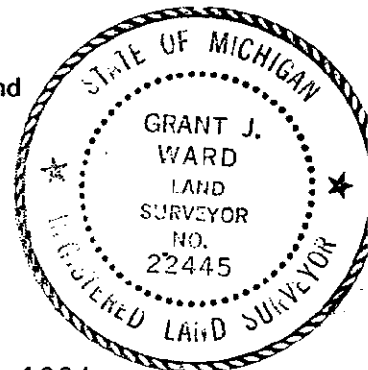

Signed by [Signature]

Date November 28, 1994

Surveyor's Michigan License No. 22445