

SURVEY & REMONUMENTATION

JAN 20 95 011235

LIBER 15213 PG 061

MAY - 1 1995

LAND CORNER RECORDATION CERTIFICATE

OK - T. SMITH

Filing Requirement of Act 74, Mich. P.A. 1970\$ 9.00

MISCELLANEOUS RECORDING

93-10101

For corners in

COMMISSION

Oakland (County)

Located In: Oakland Corner Code ##

\$ 2.00 REMONUMENTATION

20 JAN 95 7:47 A.M. RECEIPT# 118 PAID RECORDED - OAKLAND COUNTY LYNN D. ALLEN, CLERK/REGISTER OF DEEDS

Table with 3 columns: Description, Township/Range/Section, and Corner Code. Row 1: Public Land Survey, T 4N R 11E, E-13. Row 2: Property Controlling in Section, S T R. Row 3: Miscellaneous Property in Sec., S T R.

Compliance with ACT 345, P.A. 1990

APPROVED ON: 12-07-94 OAKLAND COUNTY REMONUMENTATION PEER GROUP COMMITTEE Register of Deeds Stamp & File Number

4. Lot No. , Recorded Plat Private Claims

I, Grant J. Ward, RLS in a field survey on November 15, 1994 do hereby certify that under requirements of P.A. 74, Michigan P.A. of 1970, the corner points mentioned in lines 1 and 2 above were in conformance with regulations and rules therefore as required in the current manual of survey instructions of the United States Department of the Interior, Bureau of Land Management or by a decree of a Court of Law and/or that the corner points mentioned in lines 3, 4 and 5 above were in conformance with the rules of the Michigan Board of Land Surveyors or by a Decree of a Court of Law; established, re-established, monumented, re-monumented, recovered, found as expressed below:

Grid table with columns A-M and rows 2-13. A dot is marked in cell G13.

NOTE: Not more than 4 corners, all in the same town and range, may be recorded on this certificate.

A. Description of original monument and accessories and/or subsequent restoration:

E-13 Post, per G.L.O. Notes.

B. Description of corner evidence found and/or method applied in restoring or reestablishing corner:

E-13 Corner common to Sec. 32, 33 and the Town Line, T. 4 N., R. 11 E. Found 1/2" Iron Rod in Monument Box, 1' South of the Centerline of Mead Road. This corner location is a careful and faithful perpetuation of the position of the original corner.


Previously Recorded in L. 9169, P. 207 (0) of Oakland County Records. Previously Recorded in L. 6595, P. 777 (E-1 in Avon Twp.) (1); L. 7777, P. 371 (E-1 in Avon Twp.) (1); L. 9683, P. 772 (E-1 in Avon Twp.) (1); and L. 11157, P. 094 (E-1 in Avon Twp.) (1) of Oakland County Records.

(n) Indicates the number of references that confirms this corner by dimensional tie.

C. Description of monument for corner and accessories established to perpetuate locating the position of the corner:

E-13 Corner common to Sec. 32, 33, and the Town Line, T. 4 N., R. 11 E. Set Iron Rod and Brass Cap #22445 in Monument Box.

- Due South 69.47' Set P.K. Nail & Brass Disc #22445 in E. face of Utility Pole.
S. 40° E. 61.41' Set P.K. Nail & Brass Disc #22445 in NE. face of 16" Locust.
N. 10° W. 35.50' Set P.K. Nail & Brass Disc #22445 in W. face of Utility Pole.
N. 30° E. 33.69' Set P.K. Nail & Brass Disc #22445 in SE. face of 6" Locust.
N. 13° W. 33.32' Found Iron Rod & Cap #10868.

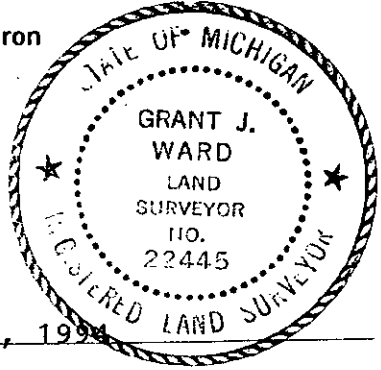

Signed by [Signature] Surveyor's Michigan License No. 22445

Date November 28, 1994

93-1010