

MAY - 1 1995

LAND CORNER RECORDATION CERTIFICATE

OK - T. SMITH

93-1010
For corners in
Oakland
(County)

COMMISSION Filing Requirement of Act 74, Mich. P.A. 1970; 9.00 MISCELLANEOUS RECORDING

\$ 2.00 REMONUMENTATION
20 JAN 95 7:47 A.M. RECEIPT# 11B
PAID RECORDED - OAKLAND COUNTY
LYNN D. ALLEN, CLERK/REGISTER OF DEEDS

Located In: Oakland Corner Code #

- 1. Public Land Survey T 4N R 11E F-7
T R
T R
T R
- 2. Property Controlling S T R
in Section S T R
- 3. Miscellaneous S T R
Property in Sec. S T R

Compliance with
ACT 345, P.A. 1990

APPROVED ON: 2-09-94
OAKLAND COUNTY REMONUMENTATION
PEER GROUP COMMITTEE
Register of Deeds Stamp & File Number

- 4. Lot No. , Recorded Plat
- 5. Private Claims

I, Grant J. Ward, RLS, in a field survey on December 22, 19 93, do hereby certify that under requirements of P.A. 74, Michigan P.A. of 1970, the corner points mentioned in lines 1 and 2 above were in conformance with regulations and rules therefore as required in the current manual of survey instructions of the United States Department of the Interior, Bureau of Land Management or by a decree of a Court of Law and/or that the corner points mentioned in lines 3, 4 and 5 above were in conformance with the rules of the Michigan Board of Land Surveyors or by a Decree of a Court of Law; established, re-established, monumented, re-monumented, recovered, found as expressed below:

	A	B	C	D	E	F	G	H	I	J	K	L	M
2	6	5	4	3	2	1							
3													
4	7	8	9	10	11	12							
5													
6	18	17	16	15	14	13							
7													
8	19	20	21	22	23	24							
9													
10	30	29	28	27	26	25							
11													
12	31	32	33	34	35	36							
13													

NOTE: Not more than 4 corners, all in the same town and range, may be recorded on this certificate.

A. Description of original monument and accessories and/or subsequent restoration:

F-7 Post, per G.L.O. Notes.

B. Description of corner evidence found and/or method applied in restoring or reestablishing corner:

F-7 Corner common to Sec. 16 and 21, T. 4 N., R. 11 E. Found 1/2" Iron Rod, 0.5' South of the Centerline of Buell Road, 0.35' below the Road surface. Fence line and tree line to the South. Tree line to the North. This corner location is a careful and faithful perpetuation of the position of the original corner.


Previously Recorded in L. 5921, P. 407 (2); and L. 11861 P. 023 (4) of Oakland County Records.

(n) Indicates the number of references that confirms this corner by dimensional tie.

C. Description of monument for corner and accessories established to perpetuate locating the position of the corner:

F-7 Corner common to Sec. 16 and 21, T. 4 N., R. 11 E. Set Iron Rod and Brass Cap #22445 adjoining Found 1/2" Iron Rod.

- S. 10° W. 18.70' Set P.K. Nail & Brass Disc #22445 in NE. face of 12" Ash.
- S. 55° W. 27.19' Set P.K. Nail & Brass Disc #22445 in NW. face of 12" Oak.
- S. 70° W. 46.09' Set P.K. Nail & Brass Disc #22445 in NW. face of 19" Walnut.
- N. 64° W. 79.16' Set P.K. Nail & Brass Disc #22445 in S. face of twin 5" Ash.

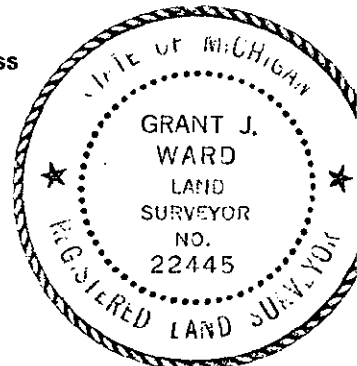

Signed by [Signature]

Date December 15, 1994

Surveyor's Michigan License No. 22445