

SURVEY & REMONUMENTATION

JAN 20 95 011238

LIBER 15213 PG 067

MAY - 1 1995

OK - T. SMITH

LAND CORNER RECORDATION CERTIFICATE

Filing Requirement of Act 74, Mich. P.A. 1970 9.00 MISCELLANEOUS RECORDING

93-1010 For corners in Oakland (County)

COMMISSION

Located In: Oakland Corner Code #F

\$ 2.00 REMONUMENTATION 20 JAN 95 7:47 A.M. RECEIPT# 11B PAID RECORDED - OAKLAND COUNTY LYNN D. ALLEN, CLERK/REGISTER OF DEEDS

Compliance with ACT 345, P.A. 1990

APPROVED ON: 2-09-94 OAKLAND COUNTY REMONUMENTATION PEER GROUP COMMITTEE Register of Deeds Stamp & File Number

Table with 3 columns: Description, Township/Range/Section, and Corner Code. Row 1: Public Land Survey, T 4N R 11E, F-9. Row 2: Property Controlling in Section, S T R. Row 3: Miscellaneous Property in Sec., S T R.

4. Lot No. , Recorded Plat 5. Private Claims

I, Grant J. Ward, RLS, in a field survey on December 16, 1993, do hereby certify that under requirements of P.A. 74, Michigan P.A. of 1970, the corner points mentioned in lines 1 and 2 above were in conformance with regulations and rules therefore as required in the current manual of survey instructions of the United States Department of the Interior, Bureau of Land Management or by a decree of a Court of Law and/or that the corner points mentioned in lines 3, 4 and 5 above were in conformance with the rules of the Michigan Board of Land Surveyors or by a Decree of a Court of Law; established, re-established, monumented, re-monumented, recovered, found as expressed below.

Grid table with columns A-M and rows 2-13. A dot is marked at the intersection of column F and row 9.

NOTE: Not more than 4 corners, all in the same town and range, may be recorded on this certificate.

A. Description of original monument and accessories and/or subsequent restoration:

F-9 Post, per G.L.O. Notes.

B. Description of corner evidence found and/or method applied in restoring or reestablishing corner:

F-9 Corner common to Sec. 21 and 28, T. 4 N., R. 11 E. Found 1/2" Iron Rod in asphalt, 3.3' North of the Centerline of Gunn Road, 59' East of the Centerline of Orion Road, 0.25' below the Road surface. Corner is 15' West of a Private Drive. Tree line to the North. This corner location is a careful and faithful perpetuation of the position of the original corner.


Previously Recorded in L. 5985, P. 811 (1) of Oakland County Records.

(n) Indicates the number of references that confirms this corner by dimensional tie.

C. Description of monument for corner and accessories established to perpetuate locating the position of the corner:

F-9 Corner common to Sec. 21 and 28, T. 4 N., R. 11 E. Set Iron Rod and Brass Cap #22445 in Concrete Monument.

- N. 65° E. 42.87' Set P.K. Nail & Brass Disc #22445 in NW. face of Utility Pole.
N. 41° W. 34.22' Set P.K. Nail & Brass Disc #22445 in SW. face of Utility Pole.
S. 15° E. 64.67' Set P.K. Nail & Brass Disc #22445 in W. face of 14" Pine.
S. 70° E. 83.76' Set P.K. Nail & Brass Disc #22445 in N. face of 20" Oak.

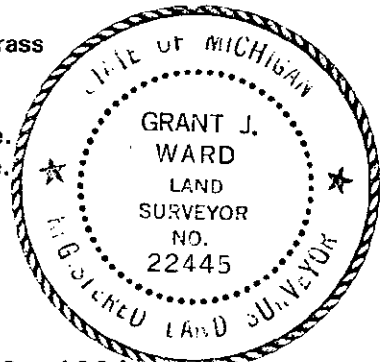

Signed by [Signature] Surveyor's Michigan License No. 22445

Date December 15, 1994