

SURVEY & REMONUMENTATION

LISEP 15213 PG 069

JAN 20 95 011239

OK - T. SMITH

93-1010 MAY - 1 1995

LAND CORNER RECORDATION CERTIFICATE

Filing Requirement of Act 74, Mich. P.A. 1970

For corners in

Oakland (County)

COMMISSION

Located In: Oakland Corner Code #

9.00 MISCELLANEOUS RECORDING

\$ 2.00 REMONUMENTATION

20 JAN 95 7:47 A.M. RECEIPT# 11B
PAID RECORDED - OAKLAND COUNTY
LYNN D. ALLEN, CLERK/REGISTER OF DEEDS

Compliance with ACT 345, P.A. 1990

APPROVED ON: 12-07-94
OAKLAND COUNTY REMONUMENTATION
PEER GROUP COMMITTEE
Register of Deeds Stamp & File Number

1. Public Land Survey	T	4N	R	11E	F-11
	T		R		
	T		R		
	T		R		
2. Property Controlling in Section	S		T	R	
	S		T	R	
3. Miscellaneous Property in Sec.	S		T	R	
	S		T	R	

4. Lot No. _____, Recorded Plat _____
5. Private Claims _____

I, Grant J. Ward, RLS in a field survey on February 17, 1994, do hereby certify that under requirements of P.A. 74, Michigan P.A. of 1970, the corner points mentioned in lines 1 and 2 above were in conformance with regulations and rules therefore as required in the current manual of survey instructions of the United States Department of the Interior, Bureau of Land Management or by a decree of a Court of Law and/or that the corner points mentioned in lines 3, 4 and 5 above were in conformance with the rules of the Michigan Board of Land Surveyors or by a Decree of a Court of Law; established, re-established, monumented, re-monumented, recovered, found as expressed below:

NOTE: Not more than 4 corners, all in the same town and range, may be recorded on this certificate.

	A	B	C	D	E	F	G	H	I	J	K	L	M
2	6		5		4		3		2				
3													
4	7		8		9		10		11		12		
5													
6	18		17		16		15		14		13		
7													
8	19		20		21		22		23		24		
9													
10	30		29		28		27		26		25		
11													
12	31		32		33		34		35		36		
13													

[Handwritten signature]

A. Description of original monument and accessories and/or subsequent restoration:

F-11 Post, per G.L.O. Notes.

B. Description of corner evidence found and/or method applied in restoring or reestablishing corner:

F-11 Corner common to Sec. 28 and 33, T. 4 N., R. 11 E. Found 1/2" Iron Pipe, 0.6' below Road surface, in the Centerline of Silverbell Road, 50' +/- East of Great Foster Drive. This corner location is a careful and faithful perpetuation of the position of the original corner.


Previously Recorded in L. 6196, P. 446 (2); L. 6216, P. 530 (2); L. 9134, P. 422 (3); L. 10204, P. 786 (3); L. 10281, P. 622 (0); L. 10292 P. 193 (1); and L. 13476, P. 673 (4) of Oakland County Records.

(n) Indicates the number of references that confirms this corner by dimensional tie.

C. Description of monument for corner and accessories established to perpetuate locating the position of the corner:

F-11 Corner common to Sec. 28 and 33, T. 4 N., R. 11 E. Set 5/8" Iron Rod and Brass Cap #22445 adjoining Found 1/2" Iron Pipe.

- S. 19° E. 38.50' Set P.K. Nail & Brass Disc #22445 in W. face of 36" Oak.
- S. 21° E. 35.32' Set P.K. Nail & Brass Disc #22445 in E. face of 6" Ash.
- N. 23° W. 77.15' Set P.K. Nail & Brass Disc #22445 in NE. face of 10" Walnut.
- N. 12° E. 53.87' Set P.K. Nail & Brass Disc #22445 in E. face of 14" Walnut.
- S. 07° E. 60.19' Found Iron Rod.

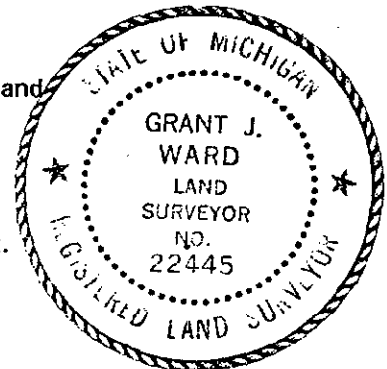

Signed by *[Signature]*

Date November 28, 1994

Surveyor's Michigan License No. 22445