

SURVEY & REMONUMENTATION

JAN 20 95 011240

LIBER 15213 PG 071

OK - T. SMITH

MAY - 1 1995

LAND CORNER RECORDATION CERTIFICATE

Filing Requirement of Act 74, Mich. P.A. 1970 9.00 MISCELLANEOUS RECORDING

93-1010

For corners in

COMMISSION

Oakland

(County)

Located In: Oakland Corner Code ##

- 1. Public Land Survey T 4N R 11E F-13  
T R  
T R  
T R
- 2. Property Controlling S T R  
in Section S T R
- 3. Miscellaneous S T R  
Property in Sec. S T R

\$ 2.00 REMONUMENTATION  
20 JAN 95 7:47 A.M. RECEIPT# 11B  
PAID RECORDED - OAKLAND COUNTY  
LYNN D. ALLEN, CLERK/REGISTER OF DEEDS

Compliance with ACT 345, P.A. 1990

APPROVED ON: 12-07-94  
OAKLAND COUNTY REMONUMENTATION  
PEER GROUP COMMITTEE  
Register of Deeds Stamp & File Number

- 4. Lot No. \_\_\_\_\_, Recorded Plat \_\_\_\_\_
- 5. Private Claims \_\_\_\_\_

	A	B	C	D	E	F	G	H	I	J	K	L	M
2	6		5		4		3		2		1		
3													
4	7		8		9		10		11		12		
5													
6	18		17		16		15		14		13		
7													
8	19		20		21		22		23		24		
9													
10	30		29		28		27		26		25		
11													
12	31		32		33		34		35		36		
13													

I, Grant J. Ward, RLS in a field survey on February 14, 1994, do hereby certify that under requirements of P.A. 74, Michigan P.A. of 1970, the corner points mentioned in lines 1 and 2 above were in conformance with regulations and rules therefore as required in the current manual of survey instructions of the United States Department of the Interior, Bureau of Land Management or by a decree of a Court of Law and/or that the corner points mentioned in lines 3, 4 and 5 above were in conformance with the rules of the Michigan Board of Land Surveyors or by a Decree of a Court of Law; established, re-established, monumented, re-monumented, recovered, found as expressed below:

NOTE: Not more than 4 corners, all in the same town and range, may be recorded on this certificate.

A. Description of original monument and accessories and/or subsequent restoration:

F-13 Post, per G.L.O. Notes.

B. Description of corner evidence found and/or method applied in restoring or reestablishing corner:


F-13 Corner common to Sec. 33 and the Town Line, T. 4 N., R. 11 E. Found 1/2" Iron Rod in the Center-line of Dutton Road, 0.35' below Road surface, 3' East of Fence line to the North. This corner location is a careful and faithful perpetuation of the position of the original corner.

Previously Recorded in L. 7177, P. 602 (3); and L. 8399, P. 174 (3) of Oakland County Records.  
Previously Recorded in L. 5961, P. 577 (F-1 in Avon Twp.) (3); L. 6595, P. 778 (F-1 in Avon Twp.) (3); and L. 11157, P. 094 (F-1 in Avon Twp.) (3) of Oakland County Records.

(n) Indicates the number of references that confirms this corner by dimensional tie.

C. Description of monument for corner and accessories established to perpetuate locating the position of the corner:

- F-13 Corner common to Sec. 33 and the Town Line, T. 4 N., R. 11 E. Set 5/8" Iron Rod and Brass Cap #22445 adjoining Found 1/2" Iron Rod.
- N. 05° W. 15.16' Set P.K. Nail & Brass Disc #22445 in S. face of 10" Maple.
- N. 20° W. 29.82' Set P.K. Nail & Brass Disc #22445 in SW. face of 20" Cherry
- S. 10° E. 21.22' Set P.K. Nail & Brass Disc #22445 in W. face of 14" Maple.
- S. 45° W. 33.88' Set P.K. Nail & Brass Disc #22445 in S. face of 20" Maple.
- Due West 26.95' Found Iron Rod 1/2".
- S. 88° W. 26.92' Found Iron Rod.
- S. 22° W. 65.56' Found Monument.

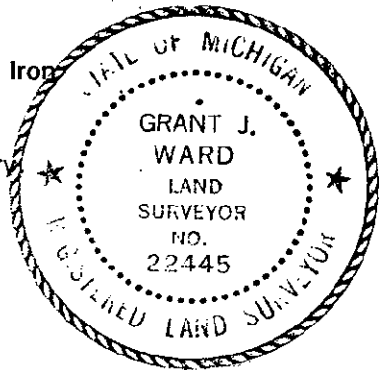

Signed by [Signature]

Date November 28, 1994

Surveyor's Michigan License No. 22445