

**SURVEY &
REMONUMENTATION**

LIBER 15213 PG 073

JAN 20 1995 011241

MAY - 1 1995 **LAND CORNER RECORDATION CERTIFICATE**

OK - T. SMITH

93-1010
For corners in
Oakland
(County)

COMMISSION

Filing Requirement of Act 74, Mich. P.A. 1976 9.00 MISCELLANEOUS RECORDING

Located In: Oakland Corner Code #

\$ 2.00 REMONUMENTATION
20 JAN 95 7:47 A.M. RECEIPT# 11B
PAID RECORDED - OAKLAND COUNTY
LYNN D. ALLEN, CLERK/REGISTER OF DEEDS

Compliance with
ACT 345, P.A. 1990

APPROVED ON: 12-29-94
OAKLAND COUNTY REMONUMENTATION
PEER GROUP COMMITTEE

Register of Deeds Stamp & File Number

- | | | |
|------------------------------------|--------------------------|------------|
| 1. Public Land Survey | T <u>4N</u> R <u>11E</u> | <u>G-4</u> |
| | T _____ R _____ | _____ |
| | T _____ R _____ | _____ |
| | T _____ R _____ | _____ |
| 2. Property Controlling in Section | S _____ T _____ R _____ | _____ |
| | S _____ T _____ R _____ | _____ |
| 3. Miscellaneous Property in Sec. | S _____ T _____ R _____ | _____ |
| | S _____ T _____ R _____ | _____ |

4. Lot No. _____, Recorded Plat _____
5. Private Claims _____

	A	B	C	D	E	F	G	H	I	J	K	L	M
2	6		5		4		3		2		1		
3													
4	7		8		9		10		11		12		
5													
6	13		17		16		15		14		13		
7													
8	19		20		21		22		23		24		
9													
10	30		29		28		27		26		25		
11													
12	31		32		33		34		35		36		

I, Grant J. Ward, RLS, in a field survey on December 28, 19 94, do hereby certify that under requirements of P.A. 74, Michigan P.A. of 1970, the corner points mentioned in lines 1 and 2 above were in conformance with regulations and rules therefore as required in the current manual of survey instructions of the United States Department of the Interior, Bureau of Land Management or by a decree of a Court of Law and/or that the corner points mentioned in lines 3, 4 and 5 above were in conformance with the rules of the Michigan Board of Land Surveyors or by a Decree of a Court of Law; established, re-established, monumented, re-monumented, recovered, found as expressed below:

NOTE: Not more than 4 corners, all in the same town and range, may be recorded on this certificate.

A. Description of original monument and accessories and/or subsequent restoration:

G-4 Post, per G.L.O. Notes.

file

B. Description of corner evidence found and/or method applied in restoring or reestablishing corner:


G-4 Corner common to Sec. 9, and 10, T. 4 N., R. 11 E. Set Concrete Monument and Brass Cap #22445, 0.5' above ground. Tree row runs East and West. This corner is a careful and faithful perpetuation of the position of the original corner.

Previously Unrecorded in Oakland County Records.

C. Description of monument for corner and accessories established to perpetuate locating the position of the corner:

G-4 Corner common to Sec. 9 and 10, T. 4 N., R. 11 E. Set Concrete Monument and Brass Cap #22445, 0.5' above ground.

- S. 80° E. 22.36' Set P.K. Nail & Brass Disc #22445 in SW. face of 14" Oak.
- Due South 8.93' Set P.K. Nail & Brass Disc #22445 in W. face of 7" Cherry.
- S. 85° W. 7.82' Set P.K. Nail & Brass Disc #22445 in SE. face of 32" Oak.
- Due West 23.52' Set P.K. Nail & Brass Disc #22445 in N. face of 30" Oak.

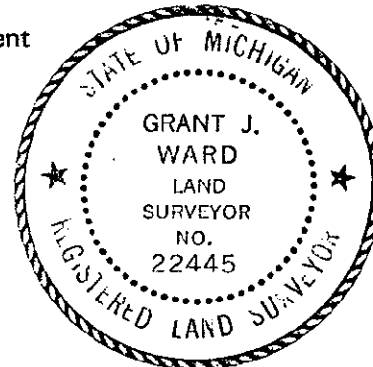

Signed by [Signature]
Surveyor's Michigan License No. 22445

Date December 30, 1994