

**SURVEY & REMONUMENTATION**

LIBER **15213** PG **077**

JAN 20 95 011243

**OK - T. SMITH**

**LAND CORNER RECORDATION CERTIFICATE**

Filing Requirement of Act 74, Mich. P.A. 1970

9.00 MISCELLANEOUS RECORDING

\$ 2.00 REMONUMENTATION

29 JAN 95 7:48 A.M. RECEIPT# 11B  
PAID RECORDED - OAKLAND COUNTY  
LYNN D. ALLEN, CLERK/REGISTER OF DEEDS

Compliance with  
ACT 345, P.A. 1990

APPROVED ON: 12-28-94  
OAKLAND COUNTY REMONUMENTATION  
PEER GROUP COMMITTEE  
Register of Deeds Stamp & File Number

93-1010

MAY - 1 1995

For corners in

**COMMISSION**

Oakland  
(County)

Located In: Oakland Corner Code ##

- |                                       |   |           |   |            |            |
|---------------------------------------|---|-----------|---|------------|------------|
| 1. Public Land Survey                 | T | <u>4N</u> | R | <u>11E</u> | <u>G-6</u> |
|                                       | T |           | R |            |            |
|                                       | T |           | R |            |            |
|                                       | T |           | R |            |            |
| 2. Property Controlling in Section    | S |           | T | R          |            |
|                                       | S |           | T | R          |            |
| 3. Miscellaneous Property in Sec.     | S |           | T | R          |            |
|                                       | S |           | T | R          |            |
| 4. Lot No. _____, Recorded Plat _____ |   |           |   |            |            |
| 5. Private Claims _____               |   |           |   |            |            |

	A	B	C	D	E	F	G	H	I	J	K	L	M
2	6	5	4	3	2	1							
3													
4	7	8	9	10	11	12							
5													
6	18	17	16	15	14	13							
7													
8	19	20	21	22	23	24							
9													
10	30	29	28	27	26	25							
11													
12	31	32	33	34	35	36							
13													

I, Grant J. Ward, RLS, in a field survey on December 17, 19 93, do hereby certify that under requirements of P.A. 74, Michigan P.A. of 1970, the corner points mentioned in lines 1 and 2 above were in conformance with regulations and rules therefore as required in the current manual of survey instructions of the United States Department of the Interior, Bureau of Land Management or by a decree of a Court of Law and/or that the corner points mentioned in lines 3, 4 and 5 above were in conformance with the rules of the Michigan Board of Land Surveyors or by a Decree of a Court of Law; established, re-established, monumented, re-monumented, recovered, found as expressed below:

**NOTE: Not more than 4 corners, all in the same town and range, may be recorded on this certificate.**

A. Description of original monument and accessories and/or subsequent restoration:

G-6 Post, per G.L.O. Notes.

B. Description of corner evidence found and/or method applied in restoring or reestablishing corner:

G-6 Corner common to Sec. 15 and 16, T. 4 N., R. 11 E. Found rock with chiseled "+" that looks more like a hole in the top of the rock. Rock is 0.8' West of a fence line running North and South. This corner location is a careful and faithful perpetuation of the position of the original corner.


Previously Recorded in L. 12838, P. 433 (4) of Oakland County Records.

(n) Indicates the number of references that confirms this corner by dimensional tie.

C. Description of monument for corner and accessories established to perpetuate locating the position of the corner:

G-6 Corner common to Sec. 15 and 16, T. 4 N., R. 11 E. Set Concrete Monument and Brass Cap #22445 in place of rock with chiseled "+".

- N. 03° W. 20.70' Set P.K. Nail & Brass Disc #22445 in W. face of 18" Oak.
- S. 83° E. 13.27' Found tack in top of hub.
- S. 06° W. 25.86' Set P.K. Nail & Brass Disc #22445 in E. face of 14" & 12" Cherry.
- N. 78° W. 10.40' Found tack in top of hub.

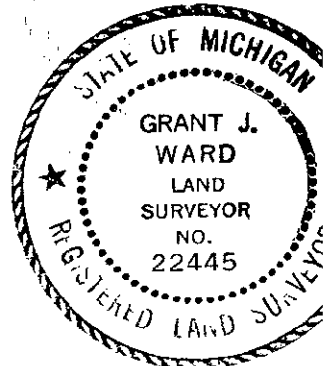

Signed by [Signature]

Date December 27, 1994

Surveyor's Michigan License No. 22445