

SURVEY & REMONUMENTATION

JAN 20 1995 011244

LIBER 15213 PG 079

OK - T. SMITH

LAND CORNER RECORDATION CERTIFICATE
Filing Requirement of Act 74, Mich. P.A. 1970

\$ 9.00 MISCELLANEOUS RECORDING
\$ 2.00 REMONUMENTATION
20 JAN 95 8:05 A.M. RECEIPT# 12B
PAID RECORDED - OAKLAND COUNTY
LYNN D. ALLEN, CLERK/REGISTER OF DEEDS

93-1010

MAY - 1 1995

For corners in

COMMISSION

Oakland
(County)

Located In: Oakland Corner Code #

- | | | | | | |
|------------------------------------|---|-----------|---|------------|------------|
| 1. Public Land Survey | T | <u>4N</u> | R | <u>11E</u> | <u>G-7</u> |
| | T | | R | | |
| | T | | R | | |
| | T | | R | | |
| 2. Property Controlling in Section | S | | T | | |
| | S | | T | | |
| 3. Miscellaneous Property in Sec. | S | | T | | |
| | S | | T | | |
4. Lot No. _____, Recorded Plat _____
5. Private Claims _____

Compliance with ACT 345, P.A. 1990
APPROVED ON: 12-07-94
OAKLAND COUNTY REMONUMENTATION PEER GROUP COMMITTEE
Register of Deeds Stamp & File Number

I, Grant J. Ward, RLS, in a field survey on December 21, 19 93, do hereby certify that under requirements of P.A. 74, Michigan P.A. of 1970, the corner points mentioned in lines 1 and 2 above were in conformance with regulations and rules therefore as required in the current manual of survey instructions of the United States Department of the Interior, Bureau of Land Management or by a decree of a Court of Law and/or that the corner points mentioned in lines 3, 4 and 5 above were in conformance with the rules of the Michigan Board of Land Surveyors or by a Decree of a Court of Law; established, re-established, monumented, re-monumented, recovered, found as expressed below:

A	B	C	D	E	F	G	H	I	J	K	L	M
2	6		5		4		3		2		1	
3												
4	7		8		9		10		11		12	
5												
6	16		17		16		15		14		13	
7												
8	19		20		21		22		23		24	
9												
10	30		29		28		27		26		25	
11												
12	31		32		33		34		35		36	
13												

NOTE: Not more than 4 corners, all in the same town and range, may be recorded on this certificate.

A. Description of original monument and accessories and/or subsequent restoration:

G-7 Post, per G.L.O. Notes.

B. Description of corner evidence found and/or method applied in restoring or reestablishing corner:

G-7 Corner common to Sec. 15, 16, 21 and 22, T. 4 N., R. 11 E. Found 1/2" Iron Rod, 0.6' below the Road surface, in the Centerline of Buell Road, 6' East of the Centerline of a gravel drive. This corner location is a careful and faithful perpetuation of the position of the original corner.


Previously Recorded in L. 6230, P. 399 (O) of Oakland County Records.

(n) Indicates the number of references that confirms this corner by dimensional tie.

C. Description of monument for corner and accessories established to perpetuate locating the position of the corner:

G-7 Corner common to Sec. 15, 16, 21 and 22, T. 4 N., R. 11 E. Set Iron Rod and Brass Cap #22445 adjoining Found 1/2" Iron Rod.

- N. 35° E. 28.32' Set P.K. Nail & Brass Disc #22445 in W. face of twin 16" Maple.
- N. 74° E. 66.86 Set P.K. Nail & Brass Disc #22445 in SE. face of twin 12" & 8" Maple.
- S. 09° W. 25.69' Set P.K. Nail & Brass Disc #22445 in E. face of twin 6" Locust.
- N. 21° W. 55.28' Set P.K. Nail & Brass Disc #22445 in SW. face of twin 8" Locust.

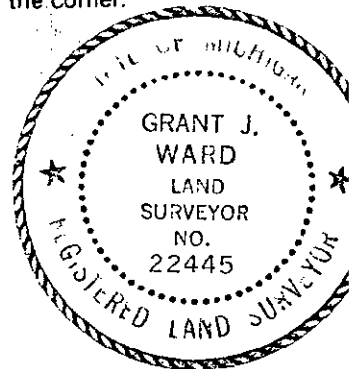

Signed by [Signature]
Surveyor's Michigan License No. 22445

Date December 15, 1994