

**SURVEY & REMONUMENTATION**

JAN 20 1995 011245

MAY - 1 1995

LIBER 15213 PG 081

COMMISSION

**LAND CORNER RECORDATION CERTIFICATE**

OK - T. SMITH

93-1010  
For corners in

Filing Requirement of Act 74, Mich. P.A. 1970

Oakland  
(County)

Located In: Oakland Corner Code #

- |                                    |   |           |   |            |            |
|------------------------------------|---|-----------|---|------------|------------|
| 1. Public Land Survey              | T | <u>4N</u> | R | <u>11E</u> | <u>G-8</u> |
|                                    | T | _____     | R | _____      | _____      |
|                                    | T | _____     | R | _____      | _____      |
|                                    | T | _____     | R | _____      | _____      |
| 2. Property Controlling in Section | S | _____     | T | _____      | _____      |
|                                    | S | _____     | T | _____      | _____      |
| 3. Miscellaneous Property in Sec.  | S | _____     | T | _____      | _____      |
|                                    | S | _____     | T | _____      | _____      |

\$ 9.00 MISCELLANEOUS RECORDING  
\$ 2.00 REMONUMENTATION  
20 JAN 95 8:05 A.M. RECEIPT# 12B  
PAID RECORDED - OAKLAND COUNTY  
LYNN D. ALLEN, CLERK/REGISTER OF DEEDS

Compliance with  
ACT 345, P.A. 1990

APPROVED ON: 2-09-94  
OAKLAND COUNTY REMONUMENTATION  
PEER GROUP COMMITTEE

Register of Deeds Stamp & File Number

4. Lot No. \_\_\_\_\_, Recorded Plat \_\_\_\_\_  
5. Private Claims \_\_\_\_\_

	A	B	C	D	E	F	G	H	I	J	K	L	M
2	6		5		4		3		2		1		
3													
4	7		8		9		10		11		12		
5													
6	18		17		16		15		14		13		
7													
8	19		20		21		22		23		24		
9													
10	30		29		28		27		26		25		
11													
12	31		32		33		34		35		36		
13													

I, Grant J. Ward, RLS, in a field survey on December 30, 19 93, do hereby certify that under requirements of P.A. 74, Michigan P.A. of 1970, the corner points mentioned in lines 1 and 2 above were in conformance with regulations and rules therefore as required in the current manual of survey instructions of the United States Department of the Interior, Bureau of Land Management or by a decree of a Court of Law and/or that the corner points mentioned in lines 3, 4 and 5 above were in conformance with the rules of the Michigan Board of Land Surveyors or by a Decree of a Court of Law; established, re-established, monumented, re-monumented, recovered, found as expressed below:

**NOTE: Not more than 4 corners, all in the same town and range, may be recorded on this certificate.**

A. Description of original monument and accessories and/or subsequent restoration:

G-8 Post, per G.L.O. Notes.

B. Description of corner evidence found and/or method applied in restoring or reestablishing corner:

G-8 Corner common to Sec. 21 & 22, T. 4 N., R. 11 E. Found Iron Pipe on fence line running East/West and 10' West of a tree line running South. This corner location is a careful and faithful perpetuation of the position of the original corner.


Previously Recorded in L. 11202, P. 589 (3) of Oakland County Records.

(n) Indicates the number of references that confirms this corner by dimensional tie.

C. Description of monument for corner and accessories established to perpetuate locating the position of the corner:

G-8 Corner common to Sec. 21 and 22, T. 4 N., R. 11 E. Set Concrete Monument and Brass Cap #22445.

- N. 72° W. 4.44' Set P.K. Nail & Brass Disc #22445 in S. face of 12" Elm.
- N. 85° W. 36.25' Set P.K. Nail & Brass Disc #22445 in S. face of 6" Elm.
- S. 82° E. 47.70' Set P.K. Nail & Brass Disc #22445 in S. face of 12" Hawthorne
- Due South 50.42' Set P.K. Nail & Brass Disc #22445 in E. face of Hawthorne Clump.
- Due East 9.19' Found Iron Rod.

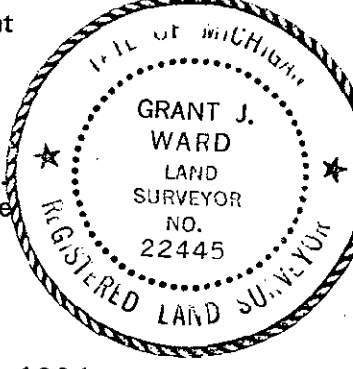

Signed by [Signature]

Date December 15, 1994

Surveyor's Michigan License No. 22445

93-1010