

SURVEY & REMONUMENTATION

LIBER 15213 PG 085

JAN 20 95 01 T 247

OK - T. SMITH

93-1010

MAY - 1 1995

LAND CORNER RECORDATION CERTIFICATE 9.00 MISCELLANEOUS RECORDING

For corners in

Filing Requirement of Act 74, Mich. P.A. 1974 2.00 REMONUMENTATION

Oakland

COMMISSION

Located In: Oakland Corner Code #

20 JAN 95 8:06 A.M. RECEIPT# 12B
PAID RECORDED - OAKLAND COUNTY
LYNN D. ALLEN, CLERK/REGISTER OF DEEDS

- 1. Public Land Survey T 4N R 11E G-10
T _____ R _____
T _____ R _____
T _____ R _____
- 2. Property Controlling S _____ T _____ R _____
in Section S _____ T _____ R _____
- 3. Miscellaneous S _____ T _____ R _____
Property in Sec. S _____ T _____ R _____

Compliance with ACT 345, P.A. 1990

APPROVED ON: 12-07-94
OAKLAND COUNTY REMONUMENTATION
PEER GROUP COMMITTEE
Register of Deeds Stamp & File Number

- 4. Lot No. _____, Recorded Plat _____
- 5. Private Claims _____

I, Grant J. Ward, RLS, in a field survey on November 17, 19 94, do hereby certify that under requirements of P.A. 74, Michigan P.A. of 1970, the corner points mentioned in lines 1 and 2 above were in conformance with regulations and rules therefore as required in the current manual of survey instructions of the United States Department of the Interior, Bureau of Land Management or by a decree of a Court of Law and/or that the corner points mentioned in lines 3, 4 and 5 above were in conformance with the rules of the Michigan Board of Land Surveyors or by a Decree of a Court of Law; established, re-established, monumented, re-monumented, recovered, found as expressed below:

	A	B	C	D	E	F	G	H	I	J	K	L	M
2	6	5	4	3	2	1							
3													
4	7	8	9	10	11	12							
5													
6	18	17	16	15	14	13							
7													
8	19	20	21	22	23	24							
9													
10	30	29	28	27	26	25							
11													
12	31	32	33	34	35	36							
13													

NOTE: Not more than 4 corners, all in the same town and range, may be recorded on this certificate.

A. Description of original monument and accessories and/or subsequent restoration:

G-10 Post, per G.L.O. Notes.

B. Description of corner evidence found and/or method applied in restoring or reestablishing corner:

G-10 Corner common to Sec. 27 and 28, T. 4 N., R. 11 E. Found Monument, 1' above ground and 43' inside of woods. This corner location is a careful and faithful perpetuation of the position of the original corner.


Previously Recorded in L. 10010, P. 617 (4); and L. 10204, P. 786 (4) of Oakland County Records.

(n) Indicates the number of references that confirms this corner by dimensional tie.

C. Description of monument for corner and accessories established to perpetuate locating the position of the corner:

G-10 Corner common to Sec. 27 and 28, T. 4 N., R. 11 E. Set Brass Cap #22445 on Found Monument.

- S. 27° E. 10.86' Set P.K. Nail & Brass Disc #22445 in NE. face of 14" Ash.
- S. 66° W. 30.59' Set P.K. Nail & Brass Disc #22445 in SE. face of 14" Oak.
- N. 80° W. 47.50' Set P.K. Nail & Brass Disc #22445 in S. face of 20" Oak.
- N. 40° W. 43.34' Set P.K. Nail & Brass Disc #22445 in S. face of 20" Oak.

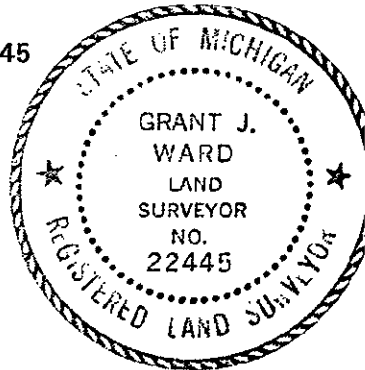

Signed by [Signature]
Surveyor's Michigan License No. 22445

Date November 28, 1994

93-1010