

**SURVEY & REMONUMENTATION**

JAN 20 95 011249

MAY - 1 1995

LIBER 15213 PC 089

OK - T. SMITH

**LAND CORNER RECORDATION CERTIFICATE**

COMMISSION

Filing Requirement of Act 74, Mich. P.A. 1970

9.00 MISCELLANEOUS RECORDING

\$ 2.00 REMONUMENTATION

20 JAN 95 8:06 A.M. RECEIPT# 12B  
PAID RECORDED - OAKLAND COUNTY  
LYNN D. ALLEN, CLERK/REGISTER OF DEEDS

93-1010

For corners in

Oakland

(County)

Located In: Oakland Corner Code #

- |                                    |   |           |   |            |             |
|------------------------------------|---|-----------|---|------------|-------------|
| 1. Public Land Survey              | T | <u>4N</u> | R | <u>11E</u> | <u>G-12</u> |
|                                    | T | _____     | R | _____      | _____       |
|                                    | T | _____     | R | _____      | _____       |
|                                    | T | _____     | R | _____      | _____       |
| 2. Property Controlling in Section | S | _____     | T | _____      | _____       |
|                                    | S | _____     | T | _____      | _____       |
| 3. Miscellaneous Property in Sec.  | S | _____     | T | _____      | _____       |
|                                    | S | _____     | T | _____      | _____       |

Compliance with ACT 345, P.A. 1990

APPROVED ON: 12-07-94  
OAKLAND COUNTY REMONUMENTATION PEER GROUP COMMITTEE  
Register of Deeds Stamp & File Number

4. Lot No. \_\_\_\_\_, Recorded Plat \_\_\_\_\_
5. Private Claims \_\_\_\_\_

	A	B	C	D	E	F	G	H	I	J	K	L	M
2	6	5	4	3	2	1							
3													
4	7	8	9	10	11	12							
5													
6	18	17	16	15	14	13							
7													
8	19	20	21	22	23	24							
9													
10	30	29	28	27	26	25							
11													
12	31	32	33	34	35	36							
13													

I, Grant J. Ward, RLS, in a field survey on November 28, 19 94, do hereby certify that under requirements of P.A. 74, Michigan P.A. of 1970, the corner points mentioned in lines 1 and 2 above were in conformance with regulations and rules therefore as required in the current manual of survey instructions of the United States Department of the Interior, Bureau of Land Management or by a decree of a Court of Law and/or that the corner points mentioned in lines 3, 4 and 5 above were in conformance with the rules of the Michigan Board of Land Surveyors or by a Decree of a Court of Law; established, re-established, monumented, re-monumented, recovered, found as expressed below:

**NOTE: Not more than 4 corners, all in the same town and range, may be recorded on this certificate.**

A. Description of original monument and accessories and/or subsequent restoration:

G-12 Post, per G.L.O. Notes.

B. Description of corner evidence found and/or method applied in restoring or reestablishing corner:

G-12 Corner common to Sec. 33 and 34, T. 4 N., R. 11 E. Found Monument, 0.7' below gravel, 1' West of the Centerline of Livernois Road. Some fence to the East. This corner location is a careful and faithful perpetuation of the position of the original corner.


Previously Recorded in L. 5935, P. 807 (1); L. 6216, P. 540 (1); L. 7503, P. 810 (NA); L. 10377, P. 369 (4); and L. 11231, P. 777 (4) of Oakland County Records.

(n) Indicates the number of references that confirms this corner by dimensional tie.  
(NA) Not Accepted.

C. Description of monument for corner and accessories established to perpetuate locating the position of the corner:

G-12 Corner common to Sec. 33 and 34, T. 4 N., R. 11 E. Set Brass Cap #22445 on existing Monument.

- S. 75° W. 20.68' Set P.K. Nail & Brass Disc #22445 in N. face of 36" Oak.
- N. 28° W. 32.74' Set P.K. Nail & Brass Disc #22445 in NE. face of 10" Ash.
- N. 50° E. 24.89' Set P.K. Nail & Brass Disc #22445 in S. face of 6" Box Elder.
- S. 30° E. 69.16' Set P.K. Nail & Brass Disc #22445 in W. face of 15" Ash.
- N. 83° E. 44.08' Found Monument.
- S. 85° W. 32.85' Found Monument.

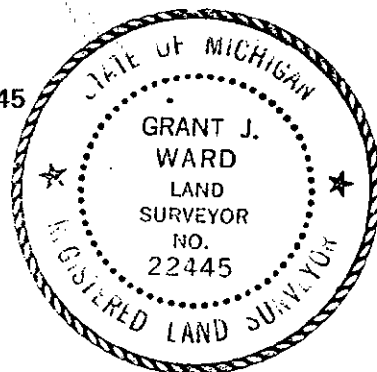

Signed by [Signature]  
Surveyor's Michigan License No. 22445

Date November 28, 1994