

**SURVEY &
REMONUMENTATION**

Jan 20 95 011250

MAY - 1 1995

LIBER 15213 PG 091

LAND CORNER RECORDATION CERTIFICATE
Filing Requirement of Act 74, Mich. P.A. 1970

OK - T. SMITH

93-1010
For corners in
Oakland
(County)

COMMISSION

Located In: Oakland Corner Code ##

\$ 9.00 MISCELLANEOUS RECORDING
\$ 2.00 REMONUMENTATION
20 JAN 95 8:06 A.M. RECEIPT# 12B
PAID RECORDED - OAKLAND COUNTY
LYNN D. ALLEN, CLERK/REGISTER OF DEEDS

Compliance with
ACT 345, P.A. 1990

APPROVED ON: 12-07-94
OAKLAND COUNTY REMONUMENTATION
PEER GROUP COMMITTEE
Register of Deeds Stamp & File Number

- | | | | | | |
|------------------------------------|---|-----------|---|------------|-------------|
| 1. Public Land Survey | T | <u>4N</u> | R | <u>11E</u> | <u>G-13</u> |
| | T | _____ | R | _____ | _____ |
| | T | _____ | R | _____ | _____ |
| | T | _____ | R | _____ | _____ |
| 2. Property Controlling in Section | S | _____ | T | _____ | _____ |
| | S | _____ | T | _____ | _____ |
| 3. Miscellaneous Property in Sec. | S | _____ | T | _____ | _____ |
| | S | _____ | T | _____ | _____ |

4. Lot No. _____, Recorded Plat _____
5. Private Claims _____

I, Grant J. Ward, RLS, in a field survey on January 3, 1994, do hereby certify that under requirements of P.A. 74, Michigan P.A. of 1970, the corner points mentioned in lines 1 and 2 above were in conformance with regulations and rules therefore as required in the current manual of survey instructions of the United States Department of the Interior, Bureau of Land Management or by a decree of a Court of Law and/or that the corner points mentioned in lines 3, 4 and 5 above were in conformance with the rules of the Michigan Board of Land Surveyors or by a Decree of a Court of Law; established, re-established, monumented, re-monumented, recovered, found as expressed below:

NOTE: Not more than 4 corners, all in the same town and range, may be recorded on this certificate.

A. Description of original monument and accessories and/or subsequent restoration:

G-13 Post, per G.L.O. Notes.

B. Description of corner evidence found and/or method applied in restoring or reestablishing corner:

G-13 Corner common to Sec. 33, 34 and the Town Line, T. 4 N., R. 11 E. Found Concrete Monument, 2.8' North of the Centerline of Dutton Road, at Road surface, 1.95' East of Found 1/2" Iron Rod. This corner location is a careful and faithful perpetuation of the position of the original corner.

Previously Unrecorded in Oakland County Records.


Previously Recorded in L. 6216, P. 542 (G-1 in Avon Twp.) (4); L. 6260, P. 664 (G-1 in Avon Twp.) (3); L. 11062, P. 241 (G-1 in Avon Twp.) (NA); and L. 11157, P. 094 (G-1 in Avon Twp.) (NA) of Oakland County Records.

(n) Indicates the number of references that confirms this corner by dimensional tie.
(NA) Not Accepted.

C. Description of monument for corner and accessories established to perpetuate locating the position of the corner:

G-13 Corner common to Sec. 33, 34, and the Town Line, T. 4 N., R. 11 E. Set Brass Cap #22445 on existing Concrete Monument.

- S. 55° W. 42.63' Set P.K. Nail & Brass Disc #22445 in SE. face of 18" Oak.
- S. 16° E. 19.58' Set P.K. Nail & Brass Disc #22445 in W. face of 4" Ash.
- N. 16° E. 28.50' Set P.K. Nail & Brass Disc #22445 in W. face of 18" Ash.
- N. 65° W. 53.02' Set P.K. Nail & Brass Disc #22445 in NE. face of Utility Pole.
- S. 86° W. 1.95' Found Iron Rod.

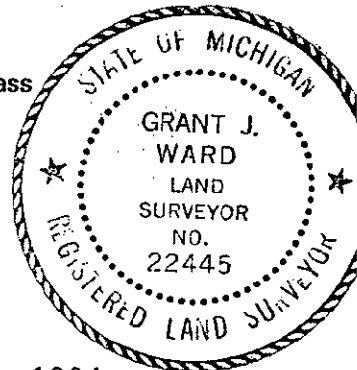

Signed by [Signature]
Surveyor's Michigan License No. 22445

Date November 28, 1994