

LAND CORNER RECORDATION CERTIFICATE  
Filing Requirement of Act 74, Mich. P.A. 1970

Compliance with  
ACT 345, P.A. 1990

93-1010 MAY - 1 1995  
For corners in

Oakland COMMISSION  
(County)

Located in: Oakland Corner Code #

APPROVED ON: 12-22-93  
OAKLAND COUNTY REMONUMENTATION  
PEER GROUP COMMITTEE  
\$ 9.00 MISCELLANEOUS RECORDING  
\$ 2.00 REMONUMENTATION  
15 NOV 94 8:59 A.M. RECEIPT# 14B  
PAID RECORDED - OAKLAND COUNTY  
LYNN D. ALLEN, CLERK/REGISTER OF DEEDS

- |                                    |   |    |   |     |     |
|------------------------------------|---|----|---|-----|-----|
| 1. Public Land Survey              | T | 4N | R | 11E | H-1 |
|                                    | T |    | R |     |     |
|                                    | T |    | R |     |     |
|                                    | T |    | R |     |     |
| 2. Property Controlling in Section | S |    | T | R   |     |
|                                    | S |    | T | R   |     |
| 3. Miscellaneous Property in Sec.  | S |    | T | R   |     |
|                                    | S |    | T | R   |     |

OK - T. SMITH

Register of Deeds Stamp & File Number

4. Lot No. \_\_\_\_\_, Recorded Plat \_\_\_\_\_  
5. Private Claims \_\_\_\_\_

	A	B	C	D	E	F	G	H	I	J	K	L
2	6	5	4	3	2	1						
3												
4	7	8	9	10	11	12						
5												
6	18	17	16	15	14	13						
7												
8	19	20	21	22	23	24						
9												
10	30	29	28	27	26	25						
11												
12	31	32	33	34	35	36						
13												

I, Grant J. Ward, RLS, in a field survey on November 23, 19 93, do hereby certify that under requirements of P.A. 74, Michigan P.A. of 1970, the corner points mentioned in lines 1 and 2 above were in conformance with regulations and rules therefore as required in the current manual of survey instructions of the United States Department of the Interior, Bureau of Land Management or by a decree of a Court of Law and/or that the corner points mentioned in lines 3, 4 and 5 above were in conformance with the rules of the Michigan Board of Land Surveyors or by a Decree of a Court of Law; established, re-established, monumented, re-monumented, recovered, found as expressed below:

NOTE: Not more than 4 corners, all in the same town and range, may be recorded on this certificate.

A. Description of original monument and accessories and/or subsequent restoration:

H-1 Post, per G.L.O. Notes.

B. Description of corner evidence found and/or method applied in restoring or reestablishing corner:

H-1 Corner common to Sec. 3 & the Town Line, T. 4 N., R. 11 E. Found 1/2" Iron Rod in Monument Box, 3.70' South of Centerline of Romeo Road. Fence line runs South. No evidence of occupation to North Township. Set Iron Rod and Brass Cap #22445, adjoining Found Iron Rod, in Monument Box. This corner has been accepted by the peer group established under Act 345 of P.A. 1990 and although not established by an original government survey, is accepted as the best available evidence of the position of the corner.


Previously Recorded in L. 6591, P. 520 (2); L. 7067, P. 313 (2); and L. 11170, P. 544 (4) of Oakland County Records.

(n) Indicates the number of references that confirm this corner by dimensional tie.

C. Description of monument for corner and accessories established to perpetuate locating the position of the corner:

H-1 Corner common to Sec. 3 & the Town Line, T. 4 N., R. 11 E. Set Iron Rod and Brass Cap #22445 in Monument Box, 3.70' South of Centerline of Romeo Road. Fence line runs South. No evidence of occupation to North Township.

- N. 35° E. 48.24' Found P.K. Nail in W. face of 18" Oak.
- N. 60° E. 59.22' Found P.K. Nail in S.E. face of 16" Oak.
- Due South 32.88' Found Iron Rod and Cap.
- N. 40° W. 54.75' Set P.K. Nail & Disc #22445 in S.W. face 16" Poplar.

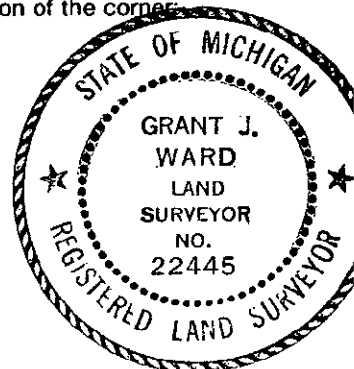

Signed by [Signature]

Date November 3, 1994

Surveyor's Michigan License No. 22445