

**SURVEY &  
REMONUMENTATION**

LIBER **15213** PG **093**

JAN 20 95 01 12 51

MAY - 1 1995

93-1010

**COMMISSION**

**LAND CORNER RECORDATION CERTIFICATE**  
Filing Requirement of Act 74, Mich. P.A. 1970

OK - T. SMITH

For corners in

Oakland

(County)

Located In: Oakland Corner Code #/

- |                                    |                          |            |
|------------------------------------|--------------------------|------------|
| 1. Public Land Survey              | T <u>4N</u> R <u>11E</u> | <u>H-5</u> |
|                                    | T _____ R _____          | _____      |
|                                    | T _____ R _____          | _____      |
|                                    | T _____ R _____          | _____      |
| 2. Property Controlling in Section | S _____ T _____ R _____  | _____      |
|                                    | S _____ T _____ R _____  | _____      |
| 3. Miscellaneous Property in Sec.  | S _____ T _____ R _____  | _____      |
|                                    | S _____ T _____ R _____  | _____      |

\$ 9.00 MISCELLANEOUS RECORDING  
\$ 2.00 REMONUMENTATION  
20 JAN 95 8:06 A.M. RECEIPT# 12B  
PAID RECORDED - OAKLAND COUNTY  
LYNN D. ALLEN, CLERK/REGISTER OF DEEDS

Compliance with  
ACT 345, P.A. 1990

APPROVED ON: 02-09-94  
OAKLAND COUNTY REMONUMENTATION  
PEER GROUP COMMITTEE  
Register of Deeds Stamp & File Number

4. Lot No. \_\_\_\_\_, Recorded Plat \_\_\_\_\_  
5. Private Claims \_\_\_\_\_

I, Grant J. Ward, RLS, in a field survey on December 21, 19 93, do hereby certify that under requirements of P.A. 74, Michigan P.A. of 1970, the corner points mentioned in lines 1 and 2 above were in conformance with regulations and rules therefore as required in the current manual of survey instructions of the United States Department of the Interior, Bureau of Land Management or by a decree of a Court of Law and/or that the corner points mentioned in lines 3, 4 and 5 above were in conformance with the rules of the Michigan Board of Land Surveyors or by a Decree of a Court of Law; established, re-established, monumented, re-monumented, recovered, found as expressed below:

**NOTE: Not more than 4 corners, all in the same town and range, may be recorded on this certificate.**

A. Description of original monument and accessories and/or subsequent restoration:

H-5 Post, per G.L.O. Notes.

B. Description of corner evidence found and/or method applied in restoring or reestablishing corner:

H-5 Corner common to Sec. 10 and 15, T. 4 N., R. 11 E. Found P.K. Nail in the Centerline of Stoney Creek Road, in the asphalt. Fence line to the North, 12' +/- East of a gravel drive. This corner location, although not established by an original government survey, is accepted as the best available evidence of the position of the corner.


Previously Recorded in L. 5892, P. 261 (3); L. 10324, P. 468 (4); L. 10855, P. 812 (4); and L. 12838, P. 433 (2) of Oakland County Records.

(n) Indicates the number of references that confirms this corner by dimensional tie.

C. Description of monument for corner and accessories established to perpetuate locating the position of the corner:

H-5 Corner common to Sec. 10 and 15, T. 4 N., R. 11 E. Set Concrete Monument and Iron Rod and Brass Cap #22445.


- Due North 44.76' Set P.K. Nail & Brass Disc #22445 in E. face of Utility Pole.
- S. 70° E. 82.00' Set P.K. Nail & Brass Disc #22445 in N. face of 7" & 5" Elm.
- S. 81° W. 76.63' Set P.K. Nail & Brass Disc #22445 in N. face of 13" Elm.
- N. 67° W. 72.26' Set P.K. Nail & Brass Disc #22445 in S. face of 5" Box Elder.

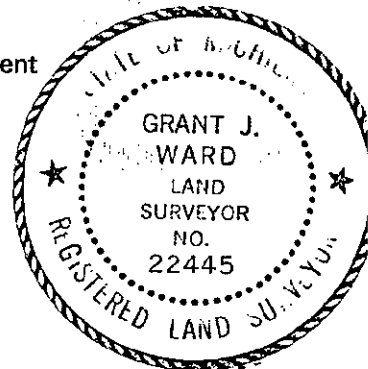

Signed by [Signature]  
Surveyor's Michigan License No. 22445

Date December 15, 1994

93-1010

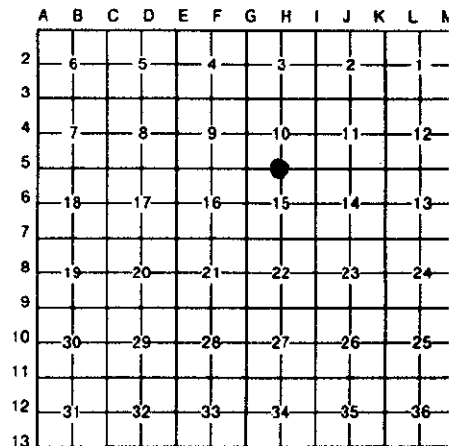

*[Handwritten initials]*