

**SURVEY &  
REMONUMENTATION**

JAN 20 95 011252

LIBER 15213 PG 095

MAY - 1 1995

**LAND CORNER RECORDATION CERTIFICATE**

OK - T. SMITH

93-1010  
For corners in  
Oakland  
(County)

**COMMISSION**

Filing Requirement of Act 74, Mich. P.A. 1970

\$ 9.00 MISCELLANEOUS RECORDING  
\$ 2.00 REMONUMENTATION  
20 JAN 95 8:06 A.M. RECEIPT# 12B  
PAID RECORDED - OAKLAND COUNTY  
LYNN D. ALLEN, CLERK/REGISTER OF DEEDS

Located In: Oakland Corner Code #H-7

Compliance with  
ACT 345, P.A. 1990

APPROVED ON: 02-09-94  
OAKLAND COUNTY REMONUMENTATION  
PEER GROUP COMMITTEE  
Register of Deeds Stamp & File Number

- |                                    |   |           |   |            |            |
|------------------------------------|---|-----------|---|------------|------------|
| 1. Public Land Survey              | T | <u>4N</u> | R | <u>11E</u> | <u>H-7</u> |
|                                    | T |           | R |            |            |
|                                    | T |           | R |            |            |
|                                    | T |           | R |            |            |
| 2. Property Controlling in Section | S |           | T |            | R          |
|                                    | S |           | T |            | R          |
| 3. Miscellaneous Property in Sec.  | S |           | T |            | R          |
|                                    | S |           | T |            | R          |
4. Lot No. \_\_\_\_\_, Recorded Plat \_\_\_\_\_
5. Private Claims \_\_\_\_\_

	A	B	C	D	E	F	G	H	I	J	K	L	I
2	6	5	4	3	2	1							
3													
4	7	8	9	10	11	12							
5													
6	18	17	16	15	14	13							
7													
8	19	20	21	22	23	24							
9													
10	30	29	28	27	26	25							
11													
12	31	32	33	34	35	36							
13													

I, Grant J. Ward, RLS, in a field survey on December 21, 19 93, do hereby certify that under requirements of P.A. 74, Michigan P.A. of 1970, the corner points mentioned in lines 1 and 2 above were in conformance with regulations and rules therefore as required in the current manual of survey instructions of the United States Department of the Interior, Bureau of Land Management or by a decree of a Court of Law and/or that the corner points mentioned in lines 3, 4 and 5 above were in conformance with the rules of the Michigan Board of Land Surveyors or by a Decree of a Court of Law; established, re-established, monumented, re-monumented, recovered, found as expressed below:

**NOTE: Not more than 4 corners, all in the same town and range, may be recorded on this certificate.**

A. Description of original monument and accessories and/or subsequent restoration:

H-7 Post, per G.L.O. Notes.

B. Description of corner evidence found and/or method applied in restoring or reestablishing corner:

H-7 Corner common to Sec. 15 and 22, T. 4 N., R. 11 E. Found 1/2" Iron Rod, 0.2' below the Road surface, 3.5' South of the Centerline of Buell Road. Tree lines to the North and South. This corner location is a careful and faithful perpetuation of the position of the original corner.


Previously Recorded in L. 6877, P. 555 (3); L. 10324 P. 469 (4); L. 10341, P. 882 (3); and L. 10855 P. 812 (4) of Oakland County Records.

(n) Indicates the number of references that confirms this corner by dimensional tie.

C. Description of monument for corner and accessories established to perpetuate locating the position of the corner:

H-7 Corner common to Sec. 15 and 22, T. 4 N., R. 11 E. Set Iron Rod and Brass Cap #22445 adjoining Found 1/2" Iron Rod.

- Due North 31.27' Set P.K. Nail & Brass Disc #22445 in E. face of Utility Pole.
- N. 71° W. 87.56' Set P.K. Nail & Brass Disc #22445 in S. face of 4" & 5" Ash.
- S. 79° W. 42.51' Set P.K. Nail & Brass Disc #22445 in N. face of 9" & 4" Elm.
- S. 10° E. 14.56' Set P.K. Nail & Brass Disc #22445 in W. face of 16" & 9" Elm.

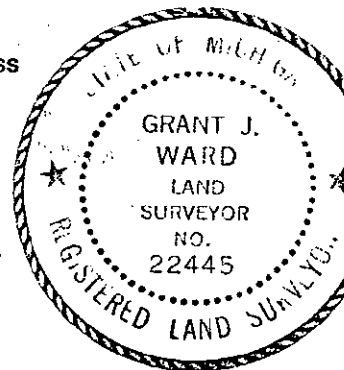

Signed by [Signature]  
Surveyor's Michigan License No. 22445

Date December 15, 1994

93-1010