

**SURVEY &  
REMONUMENTATION**

JAN 20 95 011255

MAY - 1 1995

LIBER 15213 PG 101

**LAND CORNER RECORDATION CERTIFICATE**  
Filing Requirement of Act 74, Mich. P.A. 1970

OK - T. SMITH

93-1010  
For corners in  
Oakland

**COMMISSION**

Located In: Oakland Corner Code #

\$ 9.00 MISCELLANEOUS RECORDING  
\$ 2.00 REMONUMENTATION  
20 JAN 95 8:07 A.M. RECEIPT# 128  
PAID RECORDED - OAKLAND COUNTY  
LYNN D. ALLEN, CLERK/REGISTER OF DEEDS  
Compliance with  
ACT 345, P.A. 1990

- |                                    |   |    |   |     |      |
|------------------------------------|---|----|---|-----|------|
| 1. Public Land Survey              | T | 4N | R | 11E | H-13 |
|                                    | T |    | R |     |      |
|                                    | T |    | R |     |      |
|                                    | T |    | R |     |      |
| 2. Property Controlling in Section | S |    | T | R   |      |
|                                    | S |    | T | R   |      |
| 3. Miscellaneous Property in Sec.  | S |    | T | R   |      |
|                                    | S |    | T | R   |      |

APPROVED ON: 12-07-94  
OAKLAND COUNTY REMONUMENTATION  
PEER GROUP COMMITTEE  
Register of Deeds Stamp & File Number

4. Lot No. \_\_\_\_\_, Recorded Plat \_\_\_\_\_  
5. Private Claims \_\_\_\_\_

I, Grant J. Ward, RLS, in a field survey on January 3, 1994, do hereby certify that under requirements of P.A. 74, Michigan P.A. of 1970, the corner points mentioned in lines 1 and 2 above were in conformance with regulations and rules therefore as required in the current manual of survey instructions of the United States Department of the Interior, Bureau of Land Management or by a decree of a Court of Law and/or that the corner points mentioned in lines 3, 4 and 5 above were in conformance with the rules of the Michigan Board of Land Surveyors or by a Decree of a Court of Law, established, re-established, monumented, re-monumented, recovered, found as expressed below:

	A	B	C	D	E	F	G	H	I	J	K	L
2	6	5	4	3	2	1						
3												
4	7	8	9	10	11	12						
5												
6	18	17	16	15	14	13						
7												
8	19	20	21	22	23	24						
9												
10	30	29	28	27	26	25						
11												
12	31	32	33	34	35	36						

**NOTE: Not more than 4 corners, all in the same town and range, may be recorded on this certificate.**

A. Description of original monument and accessories and/or subsequent restoration:

H-13 Post, per G.L.O. Notes.

B. Description of corner evidence found and/or method applied in restoring or reestablishing corner:

H-13 Corner common to Sec. 34 and the Town Line, T. 4 N., R. 11 E. Found 1/2" Iron Rod in concrete, 0.35' Southeast of 38" Oak. Tree row to the North, fences coming out of Oak trees to the North, South, East and West. This corner location is a careful and faithful perpetuation of the position of the original corner.


Previously Recorded in L. 8020, P. 884 (4); L. 10377, P. 368 (4); and L. 10990, P. 008 (3) of Oakland County Records.

(n) Indicates the number of references that confirms this corner by dimensional tie.

C. Description of monument for corner and accessories established to perpetuate locating the position of the corner:

H-13 Corner common to Sec. 34 and the Town Line, T. 4 N., R. 11 E. Set Brass Cap #22445 on Found 1/2" Iron Rod in concrete.

- N. 40° E. 32.04' Set P.K. Nail & Brass Disc #22445 in SE. face of 8" Cherry.
- N. 60° E. 26.22' Set P.K. Nail & Brass Disc #22445 in SE. face of 10" Cherry.
- S. 80° E. 25.88' Set P.K. Nail & Brass Disc #22445 in N. face of 14" Cherry.
- Due South 9.74' Set P.K. Nail & Brass Disc #22445 in W. face of 5" Cherry.

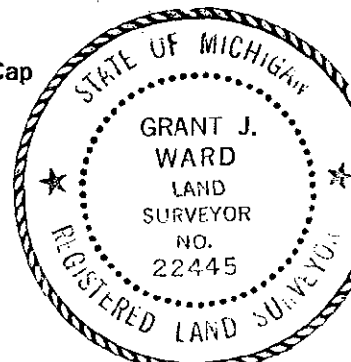

Signed by [Signature]

Date November 25, 1994

Surveyor's Michigan License No. 22445