

**SURVEY &  
REMONUMENTATION**

LIBER **15213** PG **103**

JAN 20 95 011256

MAY - 1 1995

**LAND CORNER RECORDATION CERTIFICATE**

OK - T. SMITH

93-1010

For corners in

**COMMISSION**

Filing Requirement of Act 74, Mich. P.A. 1970 9.00

MISCELLANEOUS RECORDING

\$ 2.00 REMONUMENTATION

20 JAN 95 8:07 A.M. RECEIPT# 12B  
PAID RECORDED - OAKLAND COUNTY  
LYNN D. ALLEN, CLERK/REGISTER OF DEEDS

Oakland  
(County)

Located In: Oakland Corner Code #

1. Public Land Survey	T	<u>4N</u>	R	<u>11E</u>	<u>I-1</u>
	T	_____	R	_____	_____
	T	_____	R	_____	_____
	T	_____	R	_____	_____
2. Property Controlling in Section	S	_____	T	_____	R
	S	_____	T	_____	R
3. Miscellaneous Property in Sec.	S	_____	T	_____	R
	S	_____	T	_____	R

Compliance with  
ACT 345, P.A. 1990

APPROVED ON: 12-22-93  
OAKLAND COUNTY REMONUMENTATION  
PEER GROUP COMMITTEE  
Register of Deeds Stamp & File Number

4. Lot No. \_\_\_\_\_, Recorded Plat \_\_\_\_\_  
5. Private Claims \_\_\_\_\_

I, Grant J. Ward, RLS in a field survey on November 23, 19 93, do hereby certify that under requirements of P.A. 74, Michigan P.A. of 1970, the corner points mentioned in lines 1 and 2 above were in conformance with regulations and rules therefore as required in the current manual of survey instructions of the United States Department of the Interior, Bureau of Land Management or by a decree of a Court of Law and/or that the corner points mentioned in lines 3, 4 and 5 above were in conformance with the rules of the Michigan Board of Land Surveyors or by a Decree of a Court of Law; established, re-established, monumented, re-monumented, recovered, found as expressed below:

**NOTE: Not more than 4 corners, all in the same town and range, may be recorded on this certificate.**

	A	B	C	D	E	F	G	H	I	J	K	L
2	6	5	4	3	2	1						
3												
4	7	8	9	10	11	12						
5												
6	18	17	16	15	14	13						
7												
8	19	20	21	22	23	24						
9												
10	30	29	28	27	26	25						
11												
12	31	32	33	34	35	36						
13												

A. Description of original monument and accessories and/or subsequent restoration:

I-1 Post, per G.L.O. Notes.

B. Description of corner evidence found and/or method applied in restoring or reestablishing corner:

I-1 Corner common to Sec. 2, 3 and the Town Line, T. 4 N., R. 11 E. Found 1/2" Iron in Monument Box, 4.7' South of the Centerline of Romeo Road. Tree line is running North and South. Fence to the North 43' +/- to the West. This corner location is a careful and faithful perpetuation of the position of the original corner.


Previously Recorded in L. 7067, P. 313 (2) of Oakland County Records.

(n) Indicates the number of references that confirm this corner by dimensional tie.

C. Description of monument for corner and accessories established to perpetuate locating the position of the corner:

I-1 Corner common to Sec. 2, 3 and the Town Line, T. 4 N., R. 11 E. Set 5/8" Iron Rod and Brass Cap #22445 in Monument Box.

- S. 60° W. 44.79' Set P.K. Nail & Brass Disc #22445 in N. face of 36" Maple.
- S. 30° E. 25.21' Set P.K. Nail & Brass Disc #22445 in SW. face of 16" Oak.
- N. 25° E. 56.21' Set P.K. Nail & Brass Disc #22445 in W. face of Utility Pole.
- Due South 17.13' Set P.K. Nail & Brass Disc #22445 in E. face twin 8" Elm.

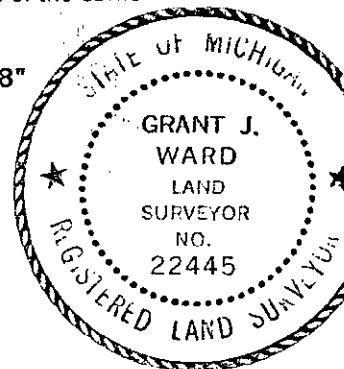

Signed by [Signature]  
Surveyor's Michigan License No. 22445

Date December 15, 1994