

**SURVEY & REMONUMENTATION**

LIBER 15095 PG 032

Nov 15 94 295387

MAY - 1 1995

**LAND CORNER RECORDATION CERTIFICATE**

93-1010  
For corners in

**COMMISSION**

Filing Requirement of Act 74, Mich. P.A. 1970

OK - T. SMITH


Oakland Located In: Oakland Corner Code #      
(County)

1. Public Land Survey	T	<u>4N</u>	R	<u>11E</u>	<u>I-3</u>
	T		R		
	T		R		
	T		R		
2. Property Controlling in Section	S		T		
	S		T		
3. Miscellaneous Property in Sec.	S		T		
	S		T		

\$ 9.00 MISCELLANEOUS RECORDING  
\$ 2.00 REMONUMENTATION  
15 NOV 94 9:00 A.M. RECEIPT# 14B  
PAID RECORDED - OAKLAND COUNTY  
LYNN D. ALLEN, CLERK/REGISTER OF DEEDS  
Compliance with ACT 345, P.A. 1990

APPROVED ON: 12-22-93  
OAKLAND COUNTY REMONUMENTATION  
PEER GROUP COMMITTEE  
Register of Deeds Stamp & File Number

4. Lot No. \_\_\_\_\_, Recorded Plat \_\_\_\_\_  
5. Private Claims \_\_\_\_\_

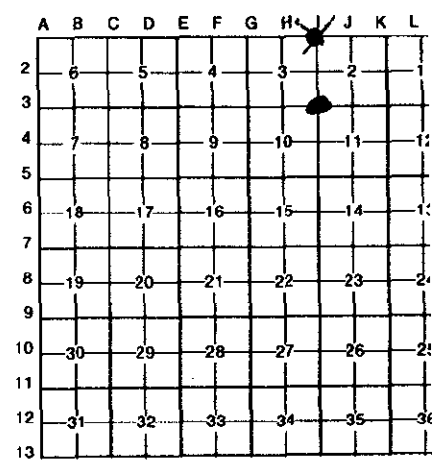

I, Grant J. Ward, RLS, in a field survey on December 6, 19 93, do hereby certify that under requirements of P.A. 74, Michigan P.A. of 1970, the corner points mentioned in lines 1 and 2 above were in conformance with regulations and rules therefore as required in the current manual of survey instructions of the United States Department of the Interior, Bureau of Land Management or by a decree of a Court of Law and/or that the corner points mentioned in lines 3, 4 and 5 above were in conformance with the rules of the Michigan Board of Land Surveyors or by a Decree of a Court of Law; established, re-established, monumented, re-monumented, recovered, found as expressed below:

**NOTE: Not more than 4 corners, all in the same town and range, may be recorded on this certificate.**

A. Description of original monument and accessories and/or subsequent restoration:

I-3 Post, per G.L.O. Notes.

B. Description of corner evidence found and/or method applied in restoring or reestablishing corner:

I-3 Corner common to Sec. 2, 3, 10 & 11, T. 4 N., R. 11 E. Found Iron Rod and Cap #15396, 4.5' South of Centerline of Predmore Road and 12.5' East of Hall Lane, 0.50' below Road surface. Set Iron Rod and Brass Cap #22445, adjoining Found Iron Rod and Cap #15396. This corner has been accepted by the peer group established under Act 345 of P.A. 1990 and is a careful and faithful perpetuation of the position of the original corner.


Previously Recorded in L. 8186, P. 652 (1) of Oakland County Records.

(n) Indicates the number of references that confirm this corner by dimensional tie.

C. Description of monument for corner and accessories established to perpetuate locating the position of the corner:

I-3 Corner common to Sec. 2, 3, 10 & 11, T. 4 N., R. 11 E. Set Iron Rod and Brass Cap #22445, 4.5' South of Centerline of Predmore Road and 12.5' East of Hall Lane, 0.50' below Road surface.

- N. 49° W. 59.82' Found P.K. Nail in S.W. face of Utility Pole.
- S. 74° W. 56.02' Set P.K. Nail and Disc #22445 in S. face of Utility Pole.
- S. 04° E. 75.41' Set P.K. Nail and Disc #22445 in W. face of 12" Maple.
- S. 66° E. 52.65' Set P.K. Nail and Disc #22445 in N. face of 12" Elm.
- N. 71° W. 14.04' Found 1/2" Iron Rod.

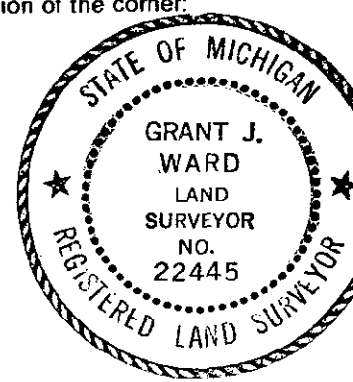

Signed by [Signature] Date November 3, 1994  
Surveyor's Michigan License No. 22445

93-1010