

**SURVEY & REMONUMENTATION**

LIBER 15095 PC 034

Nov 15 94 295388

MAY - 1 1995

**LAND CORNER RECORDATION CERTIFICATE**  
Filing Requirement of Act 74, Mich. P.A. 1970

Compliance with ACT 345, P.A. 1990

93-1010

For corners in

**COMMISSION**

APPROVED ON: 12-22-93  
OAKLAND COUNTY REMONUMENTATION  
PEER GROUP COMMITTEE

Oakland  
(County)

Located In: Oakland Corner Code #

\$ 9.00 MISCELLANEOUS RECORDING  
\$ 2.00 REMONUMENTATION  
15 NOV 94 9:00 A.M. RECEIPT# 14B  
PAID RECORDED - OAKLAND COUNTY  
LYNN D. ALLEN, CLERK/REGISTER OF DEEDS

1. Public Land Survey	T	<u>4N</u>	R	<u>11E</u>	<u>I-4</u>
	T		R		
	T		R		
	T		R		
2. Property Controlling in Section	S		T		R
	S		T		R
3. Miscellaneous Property in Sec.	S		T		R
	S		T		R

OK - T. SMITH

Register of Deeds Stamp & File Number

4. Lot No. \_\_\_\_\_, Recorded Plat \_\_\_\_\_  
5. Private Claims \_\_\_\_\_

I, Grant J. Ward, RLS, in a field survey on October 21, 19 93, do hereby certify that under requirements of P.A. 74, Michigan P.A. of 1970, the corner points mentioned in lines 1 and 2 above were in conformance with regulations and rules therefore as required in the current manual of survey instructions of the United States Department of the Interior, Bureau of Land Management or by a decree of a Court of Law and/or that the corner points mentioned in lines 3, 4 and 5 above were in conformance with the rules of the Michigan Board of Land Surveyors or by a Decree of a Court of Law; established, re-established, monumented, re-monumented, recovered, found as expressed below:

A	B	C	D	E	F	G	H	I	J	K	L
2	6	5	4	3	2						
3											
4	7	8	9	10	11						
5											
6	18	17	16	15	14						
7											
8	19	20	21	22	23						
9											
10	30	29	28	27	26						
11											
12	31	32	33	34	35						
13											

**NOTE: Not more than 4 corners, all in the same town and range, may be recorded on this certificate.**

A. Description of original monument and accessories and/or subsequent restoration:

I-4 Post, per G.L.O. Notes.

B. Description of corner evidence found and/or method applied in restoring or reestablishing corner:

I-4 Corner common to Sec. 10 & 11, T. 4 N., R. 11 E. Found Boat Spike in Monument Box in Centerline of Rochester Road, 0.30' below Road surface. Fence and tree row to West. Set Iron Rod and Brass Cap #22445, adjoining Found Boat Spike. This corner has been accepted by the peer group established under Act 345 of P.A. 1990 and is a careful and faithful perpetuation of the position of the original corner.


Previously Recorded in L. 5892, P. 257 (1); L. 6863, P. 99 (2); L. 10170, P. 058 (2); and L. 10855, P. 813 (2) of Oakland County Records.

(n) Indicates the number of references that confirm this corner by dimensional tie.

C. Description of monument for corner and accessories established to perpetuate locating the position of the corner:

I-4 Corner common to Sec. 10 & 11, T. 4 N., R. 11 E. Set Iron Rod and Brass Cap #22445 in Monument Box in Centerline of Rochester Road, 0.30' below Road surface. Fence and tree row to West.

- N. 80° W. 32.27' Set P.K. Nail and Disc #22445 in S. face of Utility Pole.
- N. 47° W. 37.46' Found P.K. Nail and Disc #17623 in S.W. face of 10" Ash.
- S. 81° E. 47.44' Set P.K. Nail and Disc #22445 in S. face of 8" Ash.
- S. 49° E. 54.58' Found P.K. Nail and Disc (no #) in N.E. face of 5" Elm.

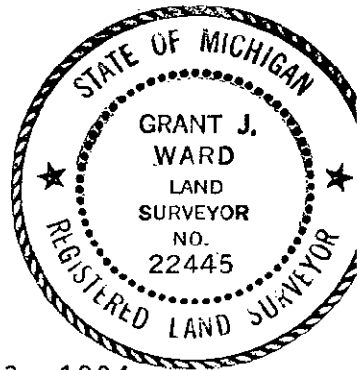

Signed by [Signature]  
Surveyor's Michigan License No. 22445

Date November 3, 1994

93-1010